

Chickasaw Co. Recorder
 Cindy Messersmith
Fee Book 2017-0995
 06/22/2017 @0350PM
 SEC COR CERT
 Book: Page: # Pages: 1
 Total Fees: \$7.00

Prepared by & Return to: Herold - Reicks Surveying, 10 East Main Street, New Hampton, IA 50659, Ph. 641-394-2725

United States Public Land Survey Corner Certificate

Land Survey Monument situated in
 Section 27, Township 96 North, Range 13 West of the Fifth Principal Meridian, Chickasaw County, Iowa.
 Not on file in the County Recorder's office.

This certificate is being prepared in compliance with Iowa Code Chapter 355.11 because:


- There is no certificate on file for this corner.
- There are no longer three valid ties of record.
- There are changes to reference ties of record.
- There is change of monumentation of record.
- To clarify description of record monument (ties).

Monument Description and Remarks:


N 1/4 Corner: Found 5/8"Ø Pipe w/1"Ø Alum. Cap RLS 2886 with information obtained from a Survey and Plat made by Lowell P. Erdman, recorded September 20, 1988, in Book 141, Page 293, on file in the Chickasaw County Recorder's Office, New Hampton, Iowa.

Plan View

(Show a minimum of three reference ties to durable physical objects, relevant monuments and physical conditions that will enable recovery of the corner.)

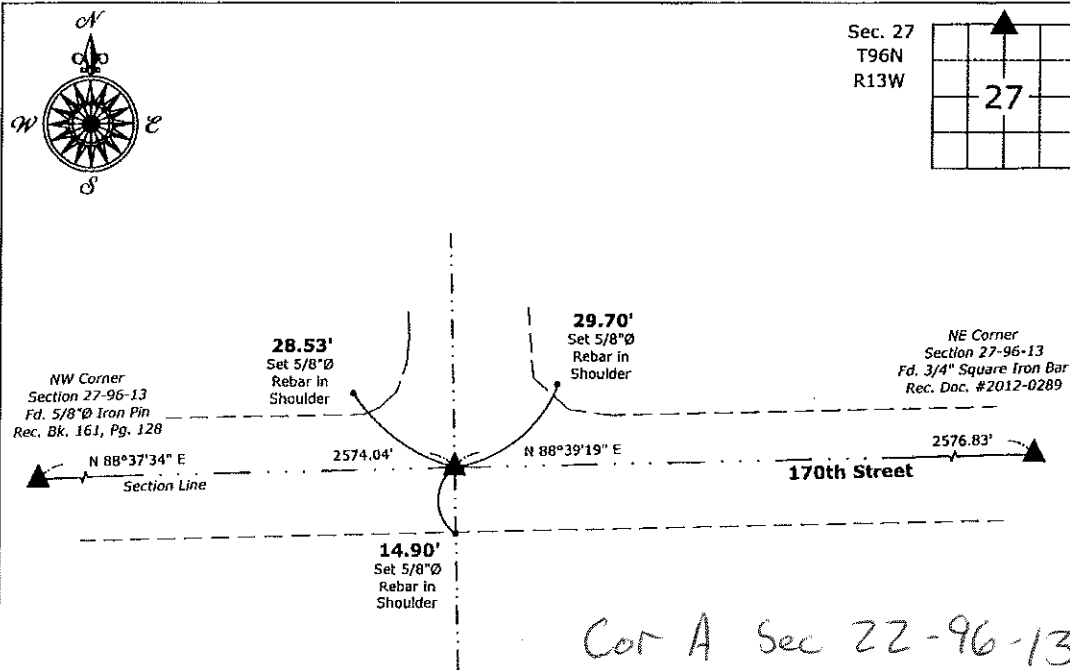

N 1/4 Corner of Section 27-96-13
 Found 5/8"Ø Pipe w/1"Ø Alum, Cap RLS 2886

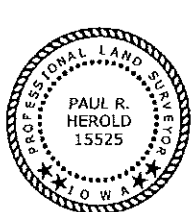

I hereby certify that this land surveying document was prepared and the related survey work was performed by me or under my direct personal supervision and that I am a duly licensed Land Surveyor under the laws of the State of Iowa.

Paul R. Herold 6-22-17
 Paul R. Herold Date:
 License number 15525
 My license renewal date is December 31, 2018.
 Sheets covered by this seal: Individual sheet only

List Corner to be Indexed			
Corner	Section	Twp.	Range
N 1/4	27	96	13

Project Number: 2017-058
 FB: Chickasaw County 9, Pgs. 5-6

File: S:_C3D Projects\County Central Systems\CHICKASAW\CHICK-20\CHICK-20.dwg, 6/22/2017 1:33:27 PM