

Instrument #: 2017-1969  
11/27/2017 11:13:54 AM Total Pages: 1  
SCC SECTION CORNER CERTIFICATES  
Recording Fee: \$ 7.00  
Cindy Messersmith, Recorder, Chickasaw County Iowa



Prepared by & Return to: Herald - Reicks Surveying, 10 East Main Street, New Hampton, IA 50659, Ph. 641-394-2725

## United States Public Land Survey Corner Certificate

Land Survey Monument situated in  
Section 29, Township 96 North, Range 13 West of the Fifth Principal Meridian, **Chickasaw** County, Iowa.  
Not on file in the County Recorder's office.

This certificate is being prepared in compliance  
with Iowa Code Chapter 355.11 because:

- There is no certificate on file for this corner.
- There are no longer three valid ties of record.
- There are changes to reference ties of record.
- There is change of monumentation of record.
- To clarify description of record monument (ties).


### Monument Description and Remarks:

**SE Corner SW 1/4 - NW 1/4:** Set 5/8"Ø rebar w/2"Ø aluminum cap PLS 15525 equidistant and on line between  
the Center of Section and West Quarter Corner of said Section.

An extensive search of all of the records within the County offices was performed as part of the section corner  
recovery, No records were located of the perpetuation of a monument at this corner.

### Plan View

(Show a minimum of three reference ties to durable physical objects, relevant monuments and physical conditions that will enable recovery of the corner.)

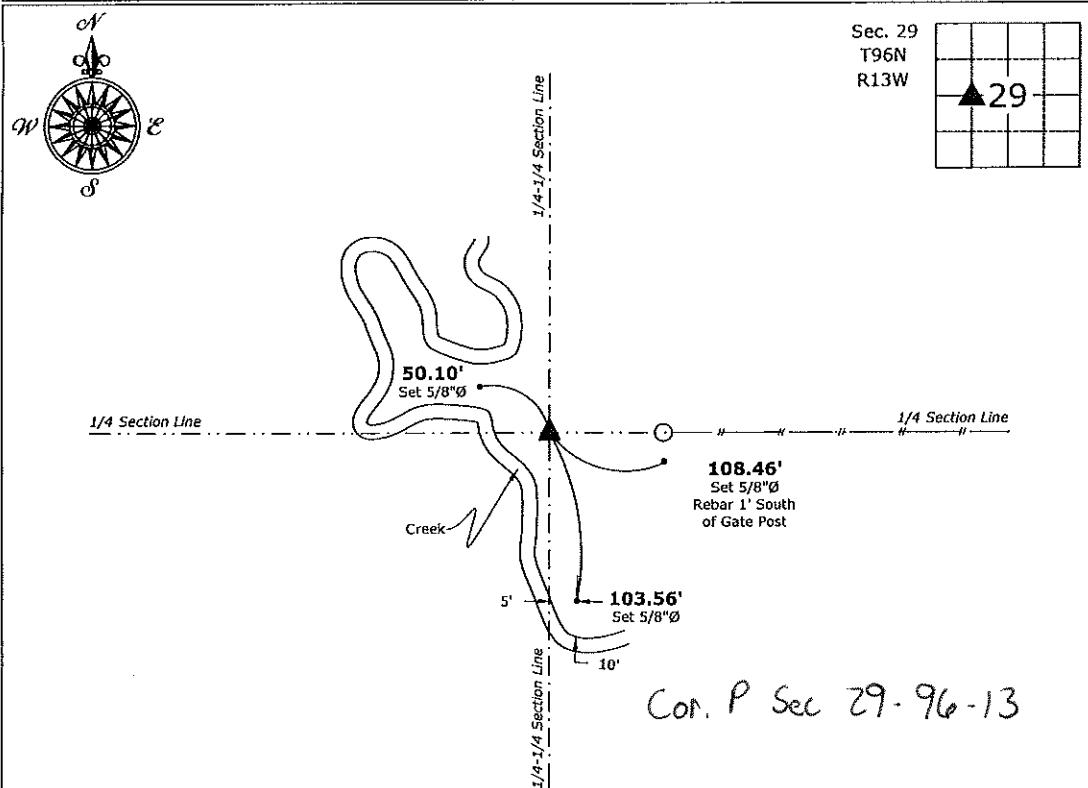

File: S:\L\CB3D Projects\County Control Systems\CHICKASAW\CHICK-19\CHICK-19.dwg, 11/22/2017 11:30:56 AM

**SE Corner of SW 1/4 - NW 1/4 Section 29-96-13**  
Set 5/8"Ø rebar w/2"Ø aluminum cap PLS 15525



I hereby certify that this land surveying document  
was prepared and the related survey work was  
performed by me or under my direct personal  
supervision and that I am a duly licensed Land  
Surveyor under the laws of the State of Iowa.

Paul R. Herold 11-22-17

Date:

License number 15525

My license renewal date is December 31, 2018.  
Sheets covered by this seal: Individual sheet only

### List Corner to be Indexed

| Corner   | Section | Twp. | Range |
|----------|---------|------|-------|
| SE SW-NW | 29      | 96   | 13    |

Project Number: 2017-104

FB: Chickasaw 8, Pgs. 44-45