

Chickasaw Co. Recorder
 Cindy Messersmith
 Fee Book 2015-1664
 12/15/2015 @0850AM
 SCC: SEC COR CERT
 Book: Page: # Pages: 1
 Total Fees: \$7.00

PREPARED BY: North Star Land Surveyors LLC, 107 Pine Street, New Hampton, IA 50659, Phone: 641-330-6948

UNITED STATES PUBLIC LAND CORNER CERTIFICATE

OF:

Land Survey Monuments situated in Section 29, Township 96 North, Range 13 West of the Fifth Principal Meridian, Chickasaw County, Iowa. Previously recorded in none previous in Office of County Recorder.

(Book, page, document number, etc.)

(Show reason for preparing this certificate, the evidence and detailed procedures used in establishing the corner positions and monumentation found or placed.)

Monument Description and Remarks :


Center Section 29 Twp. 96 Rng. 13 W.: Searched with metal locator and probed at corner fence post and at intersection of quarter section lines. Did not find evidence of center of section monumentation. Reset East 1/4 Corner and West 1/4 Corner (certificates to be recorded). Found North 1/4 Corner per certificate in document 2000-1201, County Recorder. Found South 1/4 Corner per certificate in document 2007-1911, County Recorder. Set rebar with yellow plastic cap embossed 18149 at intersection of 1/4 section lines. Corner falls app. 2.5' East and app. 12' South of corner fence post. Corner falls on extension of West and North fence lines. Reason for recording: Per Iowa Administrative Code 193C-12.2(2)b and c., set new monumentation and did not find a previous certificate on record.

PLAN -VIEW


(Show a minimum of three reference ties to durable physical objects, relevant monuments and physical conditions that will enable recovery of the corner.)



Washington Township

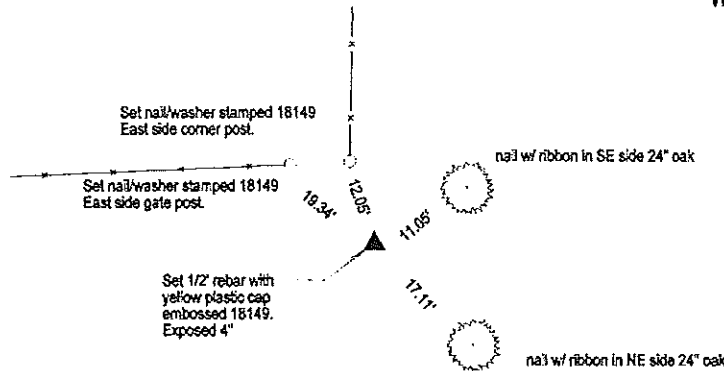

Center Section 29 Twp. 96 Rng. 13 W.

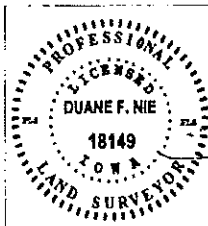

I hereby certify that this land surveying document was prepared and the related survey work was performed by me or under my direct personal supervision and that I am a duly Licensed Land Surveyor under the laws of the State of Iowa.

Duane F. Nie License number 18149 Date 12-12-15
 My license renewal date is December 31, 2016
 Pages or sheets covered by this seal. This page only

List Corners to be Indexed

Corner	Section	Township	Range
Center	29	96	13