



Prepared by & Return to: Herald - Reicks Surveying, 10 East Main Street, New Hampton, IA 50659, Ph. 641-354-2725

United States Public Land Survey Corner Certificate

Land Survey Monument situated in
Section 31, Township 96 North, Range 13 West of the Fifth Principal Meridian, Chickasaw County, Iowa.
 Not on file in the County Recorder's Office.

This certificate is being prepared in compliance
 with Iowa Code Chapter 355.11 because:


There is no certificate on file for this corner.
 There are no longer three valid ties of record.
 There are changes to reference ties of record.
 There is change of monumentation of record.
 To clarify description of record monument (ties).

Monument Description and Remarks:

West 1/4 Corner: Found 1/2"Ø rebar with information obtained from the County Engineers office.

Plan View

(Show a minimum of three reference ties to durable physical objects, relevant monuments and physical conditions that will enable recovery of the corner.)

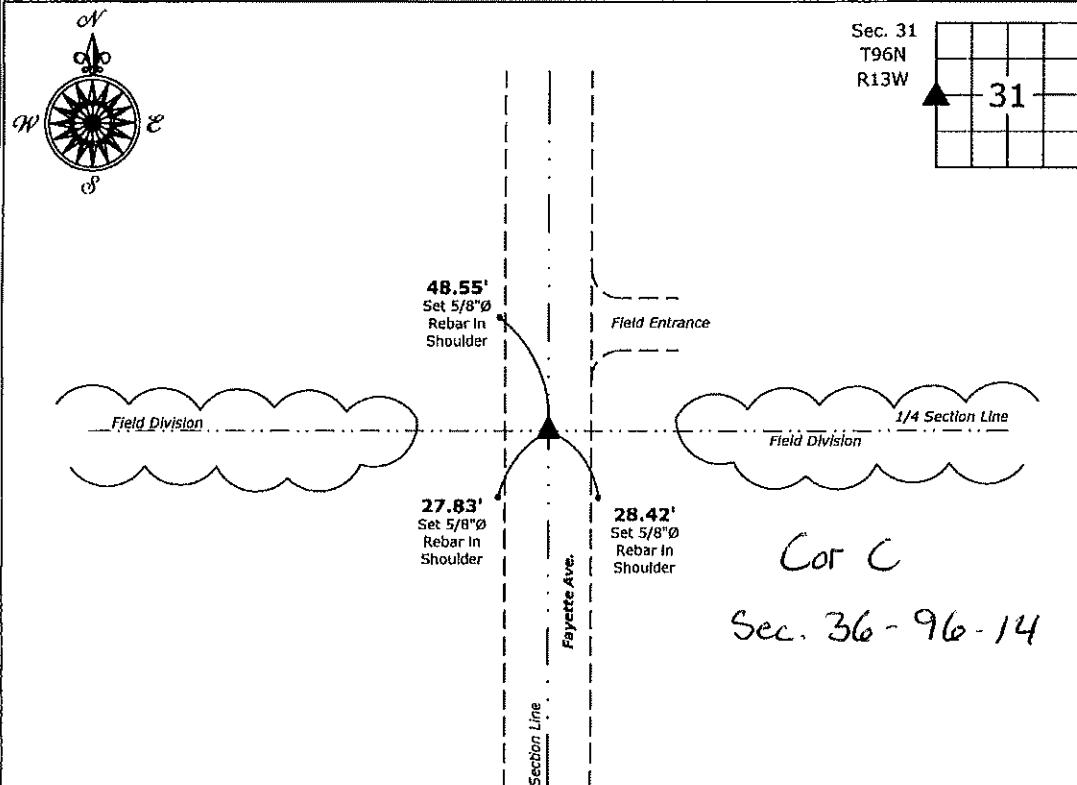

West 1/4 Corner of Section 31-96-13
 Found 1/2"Ø Rebar

 <p>KIRK D. REICKS 19211</p>	<p>I hereby certify that this land surveying document was prepared and the related survey work was performed by me or under my direct personal supervision and that I am a duly licensed Land Surveyor under the laws of the State of Iowa.</p> <p><i>Kirk D. Reicks</i> 9-17-18 Kirk D. Reicks Date: License number 19211 My license renewal date is December 31, 2018. Sheets covered by this seal: Individual sheet only</p>	<p>List Corner to be Indexed</p> <table border="1"> <thead> <tr> <th>Corner</th> <th>Section</th> <th>Twp.</th> <th>Range</th> </tr> </thead> <tbody> <tr> <td>W1/4</td> <td>31</td> <td>96</td> <td>13</td> </tr> </tbody> </table>	Corner	Section	Twp.	Range	W1/4	31	96	13
Corner	Section	Twp.	Range							
W1/4	31	96	13							
Project Number: 2018-138 FB: Chickasaw 9, Pg. 22										