

Prepared by & Return to: Herold - Reicks Surveying, 10 East Main Street, New Hampton, IA 50659, Ph. 641-394-2725

## United States Public Land Survey Corner Certificate

### Land Survey Monument situated in

**Section 32, Township 96 North, Range 13 West of the Fifth Principal Meridian, Chickasaw County, Iowa.**  
On file in **Document #2007-1910** in the County Recorder's office.

This certificate is being prepared in compliance with Iowa Code Chapter 355.11 because:


- There is no certificate on file for this corner.
- There are no longer three valid ties of record.
- There are changes to reference ties of record.
- There is change of monumentation of record.
- To clarify description of record monument (ties).

**Monument Description and Remarks:**


**Northwest Corner:** Set 1"Ø Bronze Survey Marker PLS 19211 at the previous location (Found Cut "X") with coordinates of the monument obtained prior to highway reconstruction, Project No. M-2017-2.

## Plan View

(Show a minimum of three reference ties to durable physical objects, relevant monuments and physical conditions that will enable recovery of the corner.)

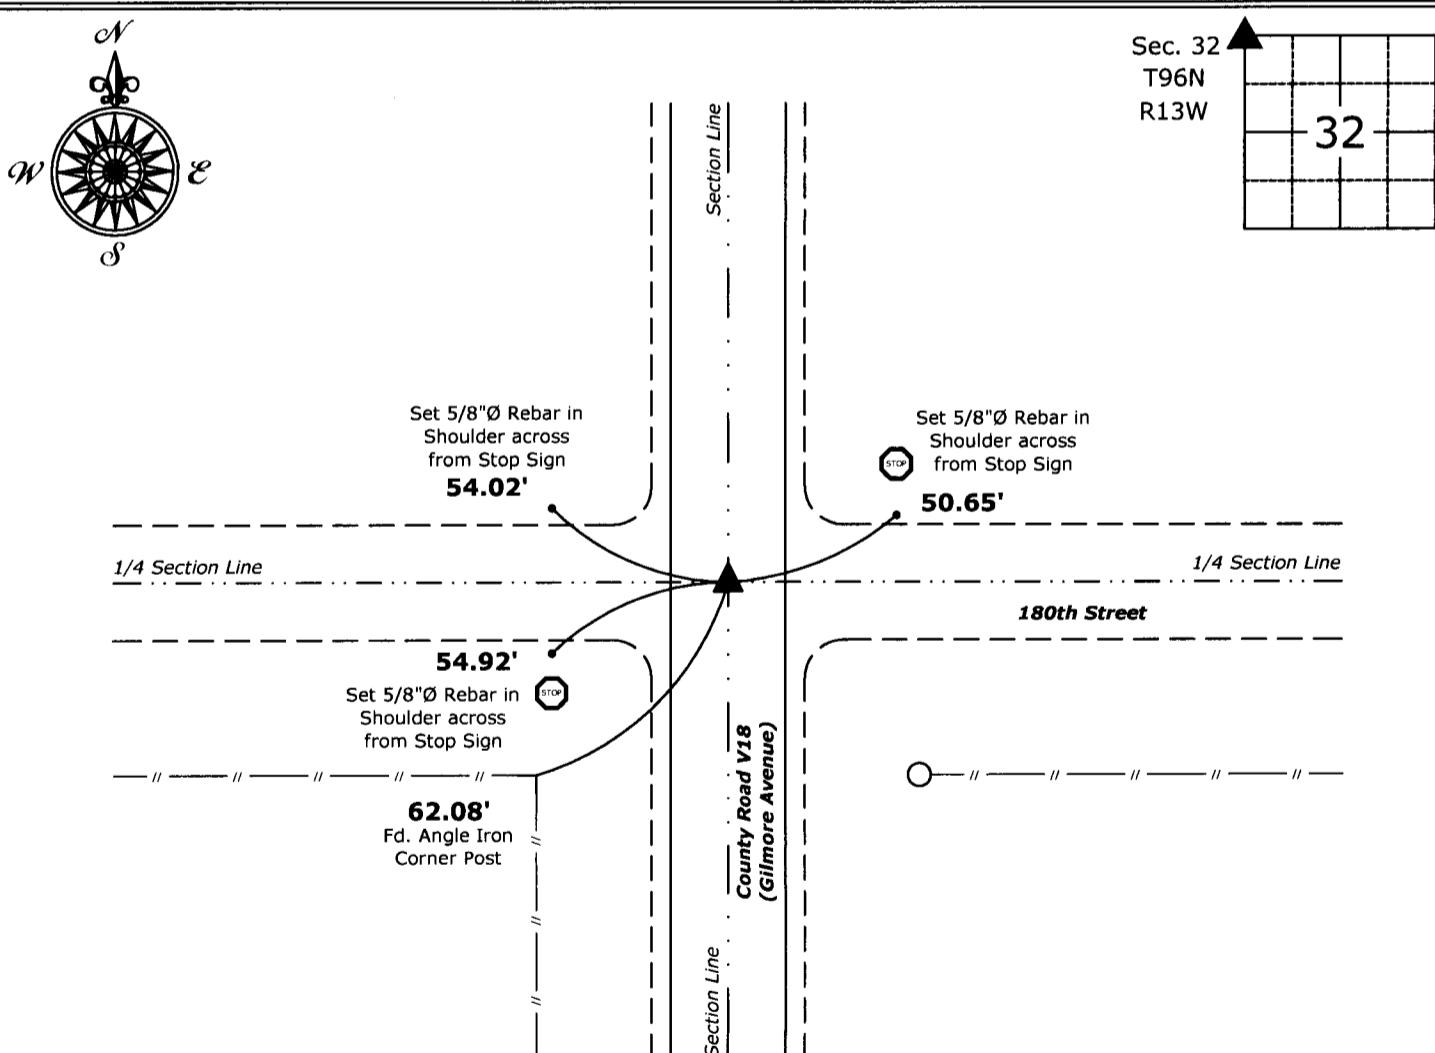

**Northwest Corner of Section 32-96-13**  
Set 1"Ø Bronze Survey Marker PLS 19211

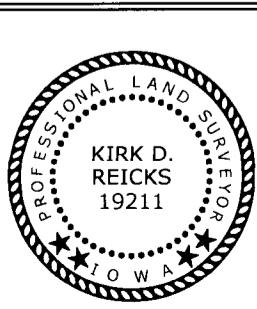

I hereby certify that this land surveying document was prepared and the related survey work was performed by me or under my direct personal supervision and that I am a duly licensed Land Surveyor under the laws of the State of Iowa.

Kirk D. Reicks 10-31-17  
Kirk D. Reicks Date:

License number 19211

My license renewal date is December 31, 2018.  
Sheets covered by this seal: Individual sheet only

### List Corner to be Indexed

Corner	Section	Twp.	Range
NW	32	96	13

Project Number: 2017-831

FB: Chickasaw 8, Pgs. 38