

Section 30-96-13
As referred to in
Engt. Tie Book

2007-1910

PREPARED BY: BRIAN J. DIEHL LS 13644 WHKS & CO. 1412 6th ST. S.W. MASON CITY, IOWA 50401 -- (641) 423-8271

SLSI 9-90

UNITED STATES PUBLIC LAND SURVEY CORNER CERTIFICATE


Land Survey Monuments Situated in Section 32³⁰, Township 96 N, Range 13 W, of the Fifth Principle Meridian, CHICKASAW County, Iowa
Previously Recorded in (NO RECORD) in County Recorder's Office

(Show reason for preparing this certificate, the evidence and detailed procedures used in establishing the corner positions and monumentation found or placed.)

Monument Description and Remarks: NW CORNER - FOUND CUT "X" IN CONCRETE
PAVING. ENGINEER'S RECORD STATES CUT "X". (7-2-96)

PLAN-VIEW

(Show a minimum of three reference ties to durable physical objects, relevant monuments and physical conditions that will enable recovery of the corner.)

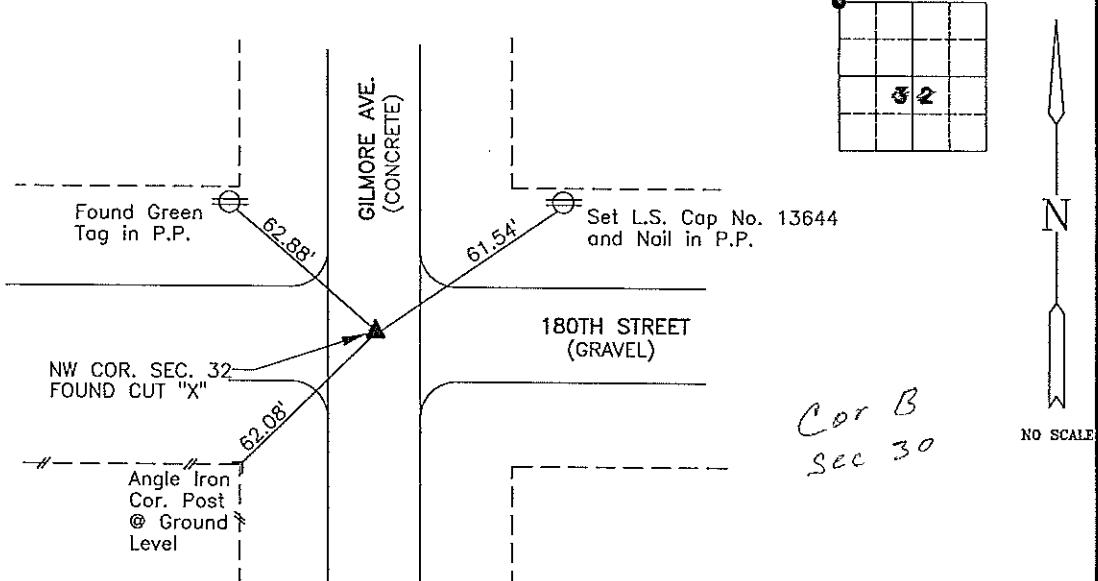


I hereby certify that this land surveying document was prepared and the related survey work was performed by me or under my direct personal supervision and that I am a duly licensed Land Surveyor under the laws of the State of Iowa.


Brian J. Diehl
License number 13644.

Section 32, 2007
Date

My license renewal date is December 31, 2007

Sheets covered by this seal: 1

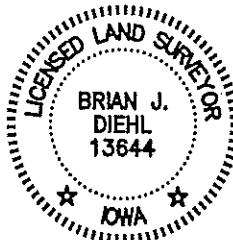

WHKS & CO.

ENGINEERS PLANNERS LAND SURVEYORS

1412 - 6th STREET S.W. P.O. BOX 1467 MASON CITY, IOWA 50402-1467
641-423-8271

JOB NO. S05107

DOCUMENT NO. **00051** | FILED FOR RECORD THE **5th** | DAY OF **July** | STATE OF IOWA, CHICKASAW COUNTY
 RECORDING FEE **\$ 6.00** | 19th 96 | AT **8:35** | RECORDER **LEITHA N. ROSS**
 S. TRANSFER FEE - **\$-----** | 161 Deed | PAGE **234** | BY **Leitha N. Ross**
 o'clock A.M. BOOK | **161** | **234** | **Leitha N. Ross** | **Deputy**

Prepared by: Erdman Engineering P.C. 708 Commerce Drive, P.O. Box 246, Decorah Iowa, 52101
 Phone (319)382-4194, Fax (319)382-3623


United States Public Land Survey Corner Certificate
of

Land Survey Monuments situated in Section **30**, Township **96**, Range **13** of the Fifth Principle Meridian, **Chickasaw** County, Iowa. Previously recorded in does not apply in County Recorders Office.


(Show reason for preparing this certificate, the evidence and detailed procedures used in establishing the corner positions and monumentation found or placed.)

Monument Description and Remarks: This certificate is prepared in accordance with Section 355.11 of the 1995 Code of Iowa. No previous certificate has been filed for this corner location. Based on County Engineer's Reference ties we found three 3/4" bars used as tie markers. We did not find any monumentation at the SE corner so we cut an "X" in the PCC pavement from county ties at the SE corner of Sec. 30-96-13. The "X" is ± 0.5 East of the Centerline Joint.

Plan-View
(Show a minimum of three reference ties to durable physical objects, relevant monuments and physical conditions that will enable recovery of the corner.)

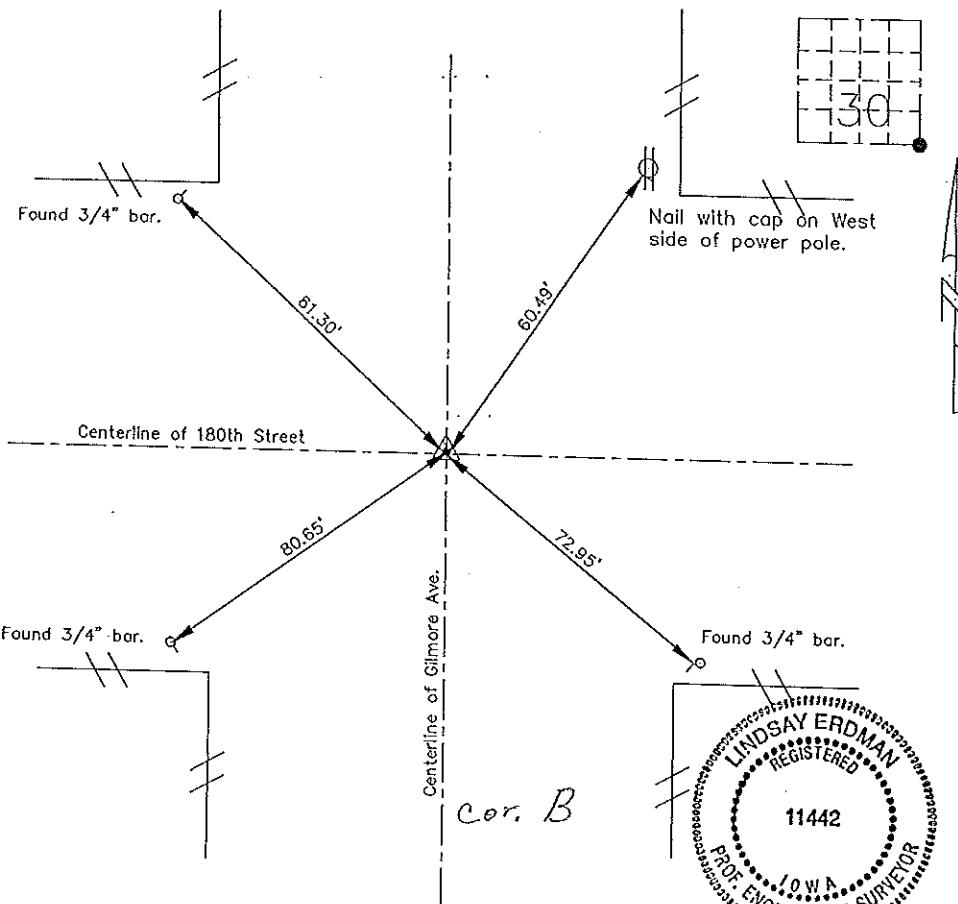

I hereby certify that the survey work was completed and this certificate was prepared by me or under my direct supervision and that I am a duly registered land surveyor under the laws of the State of Iowa.

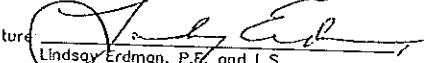Signature 
Lindsay Erdman, P.E. and L.S.

Date: 7/2/96 Reg. No. 11442

My license will be renewed January 1, 1997

List Corners to be Indexed
Corners Section Twp. Range

SE 30 96 13