

Prepared by & Return to Herold - Recke Surveying, 10 East Main Street, New Hampton, IA 50658, Ph. 641-394-2725

**UNITED STATES PUBLIC LAND SURVEY CORNER CERTIFICATE**

Land Survey Monuments situated in Section **32**, Township **96 North**, Range **13 West** of the Fifth Principal Meridian, Chickasaw County, Iowa. **1., 2.)** Not previously recorded in the County Recorder's office.

This certificate is being prepared in compliance with Iowa Code Chapter 355.11 because:


- 1 & 2  There is no certificate on file for this corner.  
 There are no longer three valid ties of record.  
 There are changes to reference ties of record.  
 There is change of monumentation of record.  
 To clarify description of record monument (ties).

**Monument Description and Remarks:**

- Northeast Corner:** Found 1/2"Ø rebar from information obtained from the Section Corner Certificate for the North 1/4 Corner of Section 32, on file in Document #2007-1911 in the County Recorder's office, New Hampton, Iowa.
- East 1/4 Corner:** Set 5/8"Ø rebar w/2"Ø aluminum cap PLS 15525 at the intersection of possession line fences from the South and Northwest after comparing distances to adjacent corners.

**PLAN - VIEW**

(Show a minimum of three reference ties to durable physical objects, relevant monuments and physical conditions that will enable recovery of the corner.)

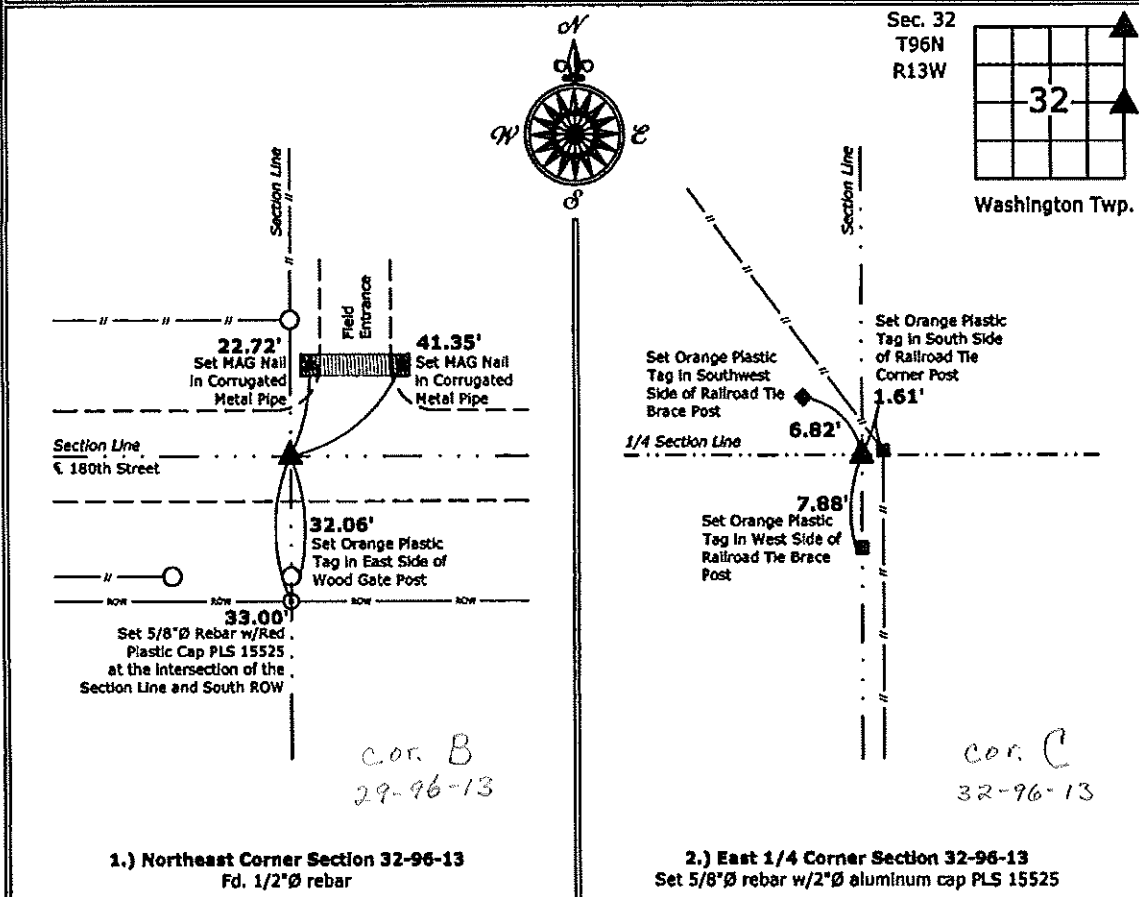

**1.) Northeast Corner Section 32-96-13**  
 Fd. 1/2"Ø rebar

**2.) East 1/4 Corner Section 32-96-13**  
 Set 5/8"Ø rebar w/2"Ø aluminum cap PLS 15525



I hereby certify that this land surveying document was prepared and the related survey work was performed by me or under my direct personal supervision and that I am a duly licensed Land Surveyor under the laws of the State of Iowa.

*Paul R. Herold 5-2-13*  
 Paul R. Herold Date:  
 License number 15525  
 My license renewal date is December 31, 2014.  
 Sheets covered by this seal: Individual sheet only

List Corners to be Indexed			
Corners	Section	Twp.	Range
NE	32	96	13
E 1/4	32	96	13

Project Number: 2013-071  
 FB: Chickasaw County 5, Pgs. 42-43