

Prepared by & Return to: Herold - Recks Surveying, 10 East Main Street, New Hampton, IA 50658, Ph. 641-394-2725

UNITED STATES PUBLIC LAND SURVEY CORNER CERTIFICATE

Land Survey Monuments situated in Section 35, Township 96 North, Range 13 West of the Fifth Principal Meridian, Chickasaw County, Iowa. 1.) & 2.) Not previously recorded in the County Recorder's office.

This certificate is being prepared in compliance with Iowa Code Chapter 355.11 because:

- 1 & 2 There is no certificate on file for this corner.
 There are no longer three valid ties of record.
 There are changes to reference ties of record.
 There is change of monumentation of record.
 To clarify description of record monument (ties).


Monument Description and Remarks:

1.) Northwest Corner SW 1/4-NE 1/4: Fd. 1/2"Ø rebar with 1.5"Ø aluminum cap PLS 2886 from information on a survey and plat made by L.P. Erdman, recorded in Book 144, Page 123, on file in the Chickasaw County Recorder's Office, New Hampton, Iowa.

2.) Northeast Corner SE 1/4-NE 1/4: Set Survey Mark Nail w/ Stainless Steel Washer PLS 15525 equidistant and on line between the NE Corner and the E 1/4 Corner of the Section.

PLAN - VIEW

(Show a minimum of three reference ties to durable physical objects, relevant monuments and physical conditions that will enable recovery of the corner.)

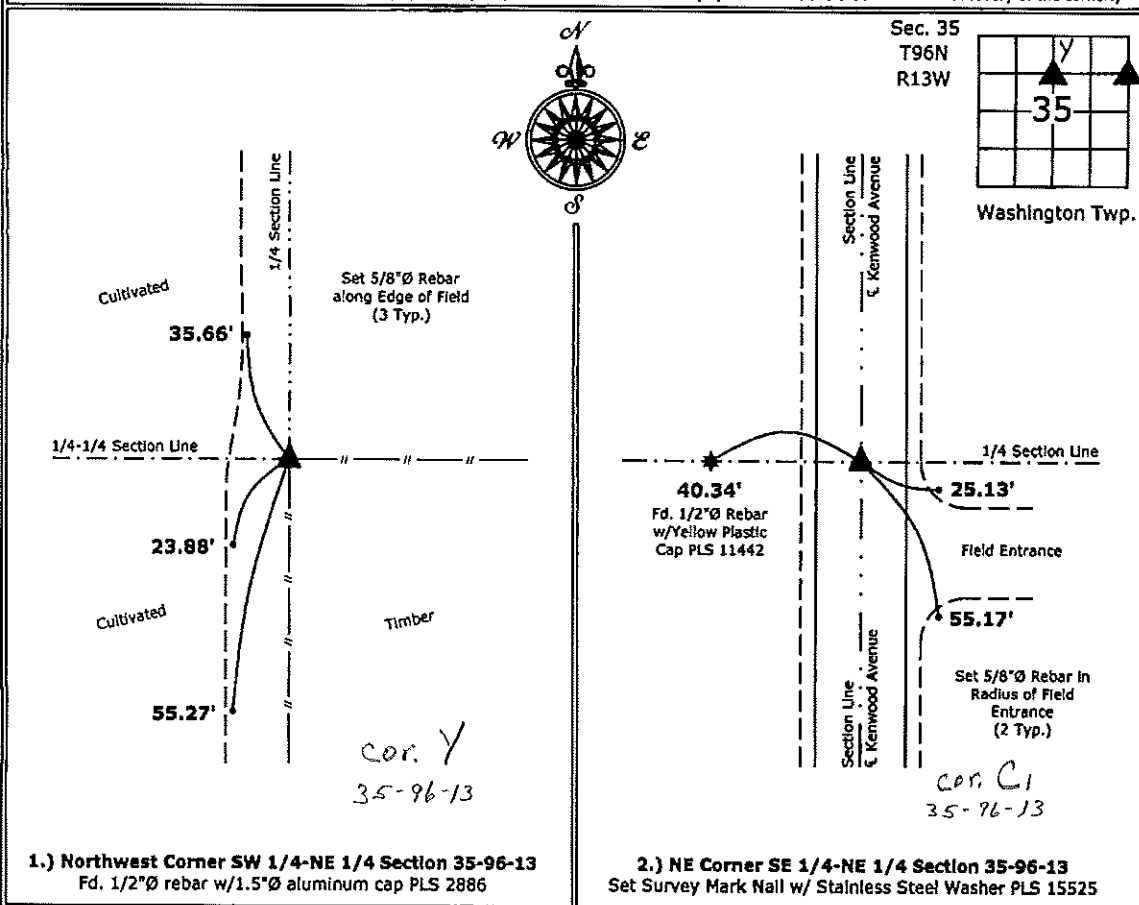

1.) Northwest Corner SW 1/4-NE 1/4 Section 35-96-13
 Fd. 1/2"Ø rebar w/1.5"Ø aluminum cap PLS 2886

2.) NE Corner SE 1/4-NE 1/4 Section 35-96-13
 Set Survey Mark Nail w/ Stainless Steel Washer PLS 15525



I hereby certify that this land surveying document was prepared and the related survey work was performed by me or under my direct personal supervision and that I am a duly licensed Land Surveyor under the laws of the State of Iowa.

Paul R. Herold 8-22-13
 Paul R. Herold Date:
 License number 15525
 My license renewal date is December 31, 2014.
 Sheets covered by this seal: Individual sheet only

List Corners to be Indexed			
Corners	Section	Twp.	Range
NW-SW-NE	35	96	13
NE-SE-NE	35	96	13

Project Number: 2013-127
 FB: Chickasaw 5, Pgs. 54-55