

Instr. Number: 2022-1204  
Recorded: 6/27/2022 at 3:58:28.0 PM  
Pages 1  
County Recording Fee: \$7.00  
Iowa E-Filing Fee: \$3.00  
Combined Fee: \$10.00  
Revenue Tax:  
Shirley Troyna RECORDER  
Chickasaw County, Iowa

Prepared by & Return to: Herald - Reicks Surveying, 10 East Main Street, New Hampton, IA 50659, Ph. 641-394-2725

## Corrective United States Public Land Survey Corner Certificate

Land Survey Monument situated in  
Section **36**, Township **96** North, Range **13** West of the Fifth Principal Meridian, **Chickasaw** County, Iowa.  
Not on file in the County Recorder's Office.

This certificate is being prepared in compliance  
with Iowa Code Chapter 355.11 because:

- There is no certificate on file for this corner.
- There are no longer three valid ties of record.
- There are changes to reference ties of record.
- There is change of monumentation of record.
- To clarify description of record monument (ties).

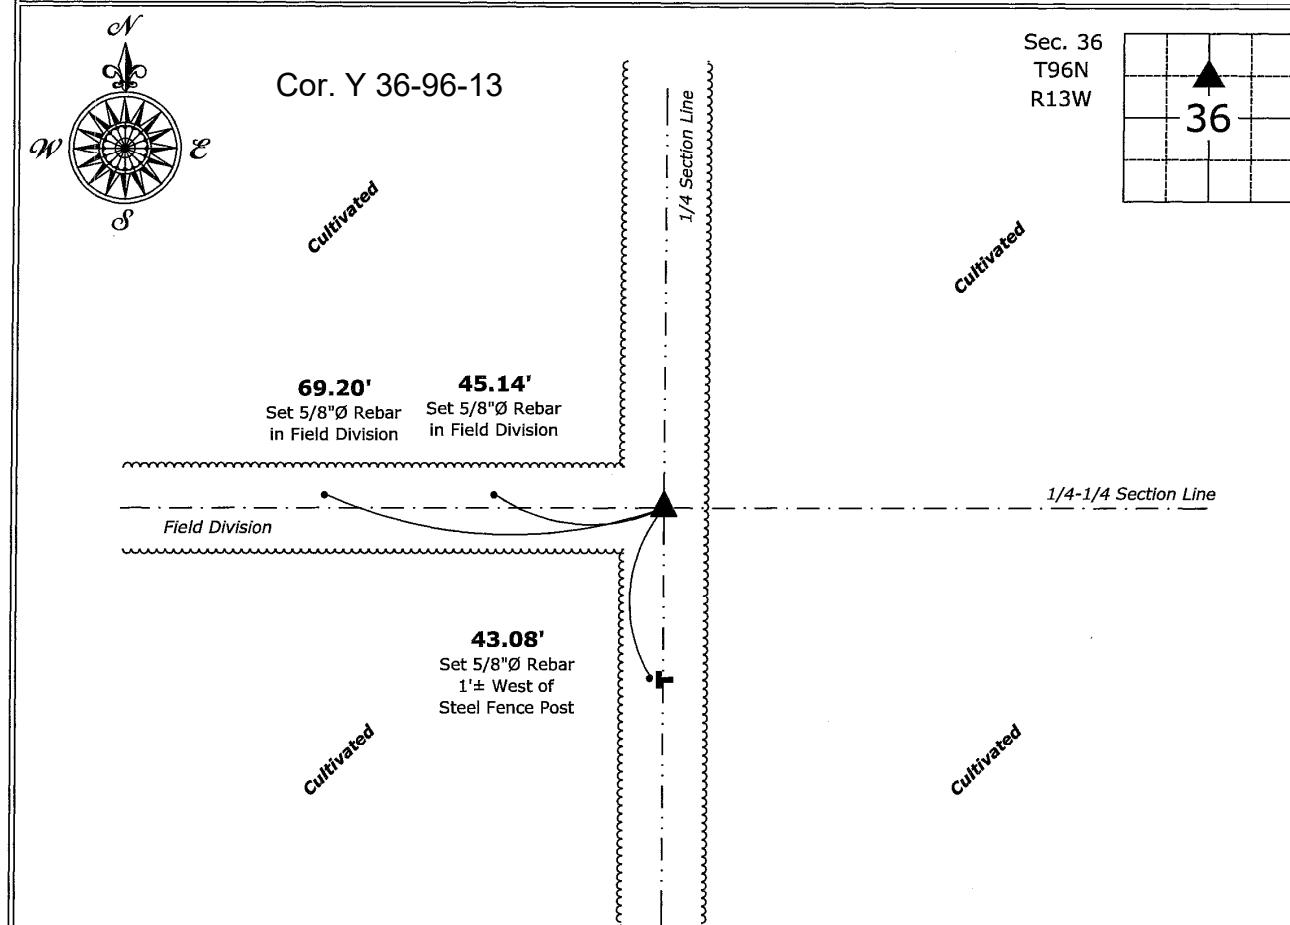
### Monument Description and Remarks:

**Northeast Corner of the SE 1/4 - NW 1/4:** Set 5/8"Ø Rebar w/2"Ø Aluminum Cap PLS 19211 equidistant and on line between the Center and North Quarter Corners of said Section.

This Corrective Section Corner Certificate is being prepared to clarify the Corner to be indexed and supercedes Document #2022-1076, on file in the County Recorder's Office.

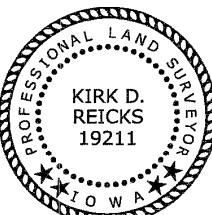
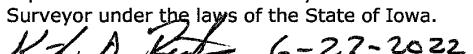
### Plan View

(Show a minimum of three reference ties to durable physical objects, relevant monuments and physical conditions that will enable recovery of the corner.)



### Northeast Corner of the SE 1/4 - NW 1/4 of Section 36-96-13

Set 5/8"Ø Rebar w/2"Ø Aluminum Cap PLS 19211

 <p>KIRK D. REICKS 19211</p>	I hereby certify that this land surveying document was prepared and the related survey work was performed by me or under my direct personal supervision and that I am a duly licensed Land Surveyor under the laws of the State of Iowa.   Kirk D. Reicks Date: 6-27-2022 License number 19211 My license renewal date is December 31, 2022. Sheets covered by this seal: Individual sheet only	<p>List Corner to be Indexed</p> <table border="1"><thead><tr><th>Corner</th><th>Section</th><th>Twp.</th><th>Range</th></tr></thead><tbody><tr><td>NE-SE-NW</td><td>36</td><td>96</td><td>13</td></tr></tbody></table> <p>Project Number: 2022-070</p> <p>FB: Chickasaw 11, Pgs. 49-51</p>	Corner	Section	Twp.	Range	NE-SE-NW	36	96	13
Corner	Section	Twp.	Range							
NE-SE-NW	36	96	13							