



Prepared by & Return to: Herold - Reicks Surveying, 10 East Main Street, New Hampton, IA 50659, Ph. 641-394-2725

United States Public Land Survey Corner Certificate

Land Survey Monument situated in
 Section 5, Township 96 North, Range 13 West of the Fifth Principal Meridian, **Chickasaw** County, Iowa.
 On file in **Document #2001-0958** in the County Recorder's office.

This certificate is being prepared in compliance
 with Iowa Code Chapter 355.11 because:


There is no certificate on file for this corner.
 There are no longer three valid ties of record.
 There are changes to reference ties of record.
 There is change of monumentation of record.
 To clarify description of record monument (ties).

Monument Description and Remarks:

Southwest Corner: Set 5/8"Ø Rebar with Aluminum Cap PLS 19211 in PCC Center Line Joint with Information obtained from previous Section Corner Certificate. The previous monument was missing.

Plan View


(Show a minimum of three reference ties to durable physical objects, relevant monuments and physical conditions that will enable recovery of the corner.)

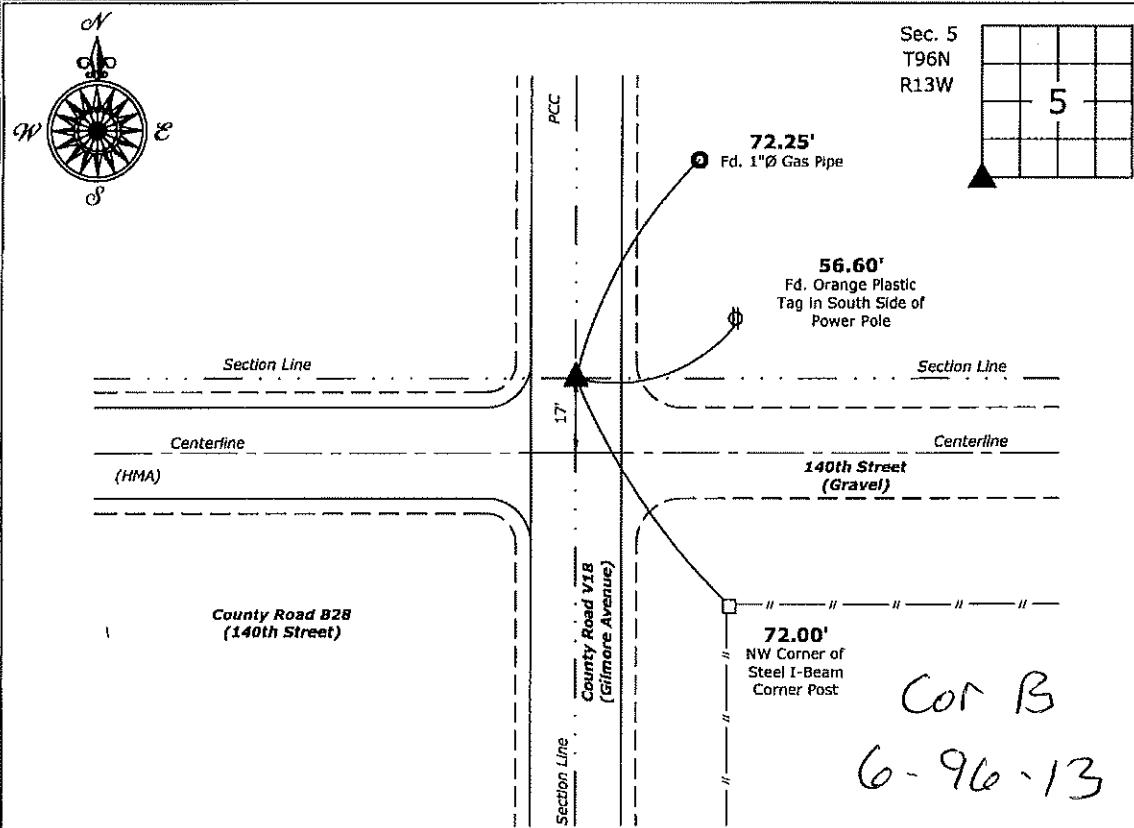

File: S:_Projects - NHO\County Central Systems - NHO\CHICKASAW\CHICK-11\CHICK-11.dwg, 4/5/2019 10:21:20 AM

Southwest Corner of Section 5-96-13

Set 5/8"Ø Rebar with Aluminum Cap PLS 19211

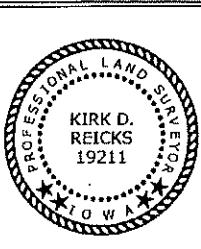

I hereby certify that this land surveying document was prepared and the related survey work was performed by me or under my direct personal supervision and that I am a duly licensed Land Surveyor under the laws of the State of Iowa.

Kirk D. Reicks 4-5-19

Kirk D. Reicks

Date:

License number 19211

My license renewal date is December 31, 2020.

Sheets covered by this seal: Individual sheet only

List Corner to be Indexed

Corner	Section	Twp.	Range
SW	5	96	13

Project Number: 2019-029

FB: Chickasaw 9, Pgs. 34-35