

COPY

FILED 2003-0744  
RECORDER'S OFFICE  
CHICKASAW COUNTY, IOWA  
2003 MAR 12 AM 9 13  
CINDY MESSERSMITH  
COUNTY RECORDER

TeKIPPE ENGINEERING, P.C., 128 South Vine Street, West Union, Iowa 52176 Phone (563) 422-6131

UNITED STATES PUBLIC LAND SURVEY CORNER CERTIFICATE

OF

Land Survey Monuments situated in Section 3, Township 96 North, Range 13 West of the Fifth Principal Meridian, CHICKASAW County, Iowa. Previously recorded in none in County Recorder's Office. (book, page, document number, etc.)



(Show reason for preparing this certificate, the evidence and detailed procedures used in establishing the corner positions and monumentation found or placed.)

Monument Description and Remarks: **SW Corner Section 3 T96N R13W:** Found 1/2"Ø iron pin with information obtained from the Chickasaw County Engineer's Office in Field Book Washington Twp. Corner Ties, Section 4, Corner 'B', and with information obtained from a Survey and Plat made by Lyle G. TeKippe recorded in the Chickasaw County Recorder's Office May 19, 1988 in Deeds Book 140, Pages 425-426.  
**S 1/4 Corner Section 3 T96N R13W:** Found 1/2"Ø iron pin with information obtained from the Chickasaw County Engineer's Office in Field Book Washington Twp. Corner Ties, Section 3, Corner 'A'.

PLAN - VIEW

Project Number 03016.LS  
FB. 46J PG. 62-65

(Show a minimum of three reference ties to durable physical objects, relevant monuments and physical conditions that will enable recovery of the corner.)

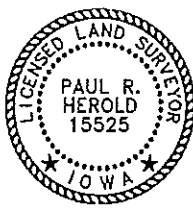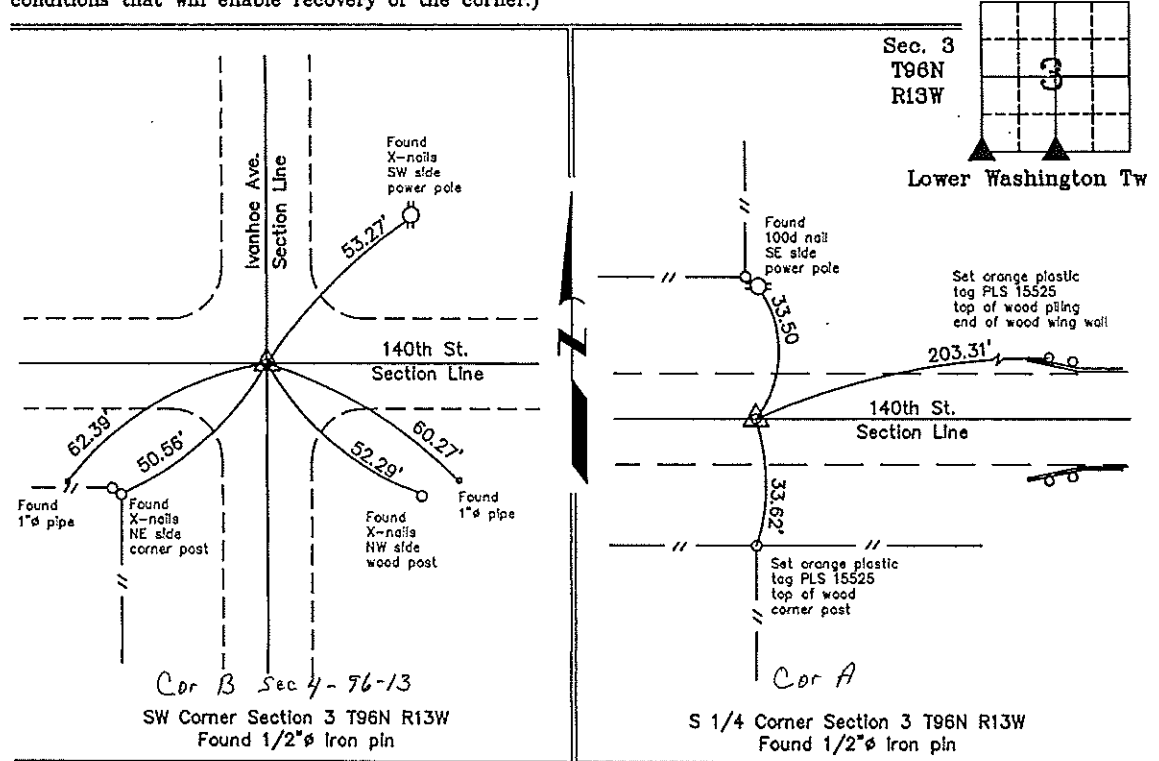

I hereby certify that this land surveying document was prepared and the related survey work was performed by me or under my direct personal supervision and that I am a duly Licensed Land Surveyor under the laws of the State of Iowa.

*Paul R. Herold* 3-10-03  
Paul R Herold Date  
License number 15525  
My license renewal date is December 31, 2004.  
Sheets covered by this seal: Individual

List Corners to be Indexed			
Corners	Section	Twp.	Range
SW	3	96N	13W
S 1/4	3	96N	13W

Filed 3-12-03

County Engineer  
Adm.