

Prepared by & Return to: Herold - Reicks Surveying, 10 East Main Street, New Hampton, IA 50658, Ph. 641-394-2725

UNITED STATES PUBLIC LAND SURVEY CORNER CERTIFICATE

Land Survey Monuments situated in Section 20, Township 97 North, Range 13 West of the Fifth Principal Meridian, Chickasaw County, Iowa. 1., 2.) Not previously recorded in the County Recorder's office.

This certificate is being prepared in compliance with Iowa Code Chapter 355.11 because:

- 1 & 2 There is no certificate on file for this corner.
 There are no longer three valid ties of record.
 There are changes to reference ties of record.
 There is change of monumentation of record.
 To clarify description of record monument (ties).


Monument Description and Remarks:

1.) **Center of Section:** Set 5/8"Ø rebar with 2"Ø aluminum Cap PLS 15525 at an existing fence corner from information obtained from the County Engineer's office regarding the prior establishment of the corner. The fence was accepted as evidence of perpetuation of the position.

2.) **East 1/4 Corner:** Found 8"x12" Stone from information obtained from the County Engineer's office. Set 5/8"Ø rebar 0.53' South of high point of stone in accessory to corner.

PLAN - VIEW

(Show a minimum of three reference ties to durable physical objects, relevant monuments and physical conditions that will enable recovery of the corner.)

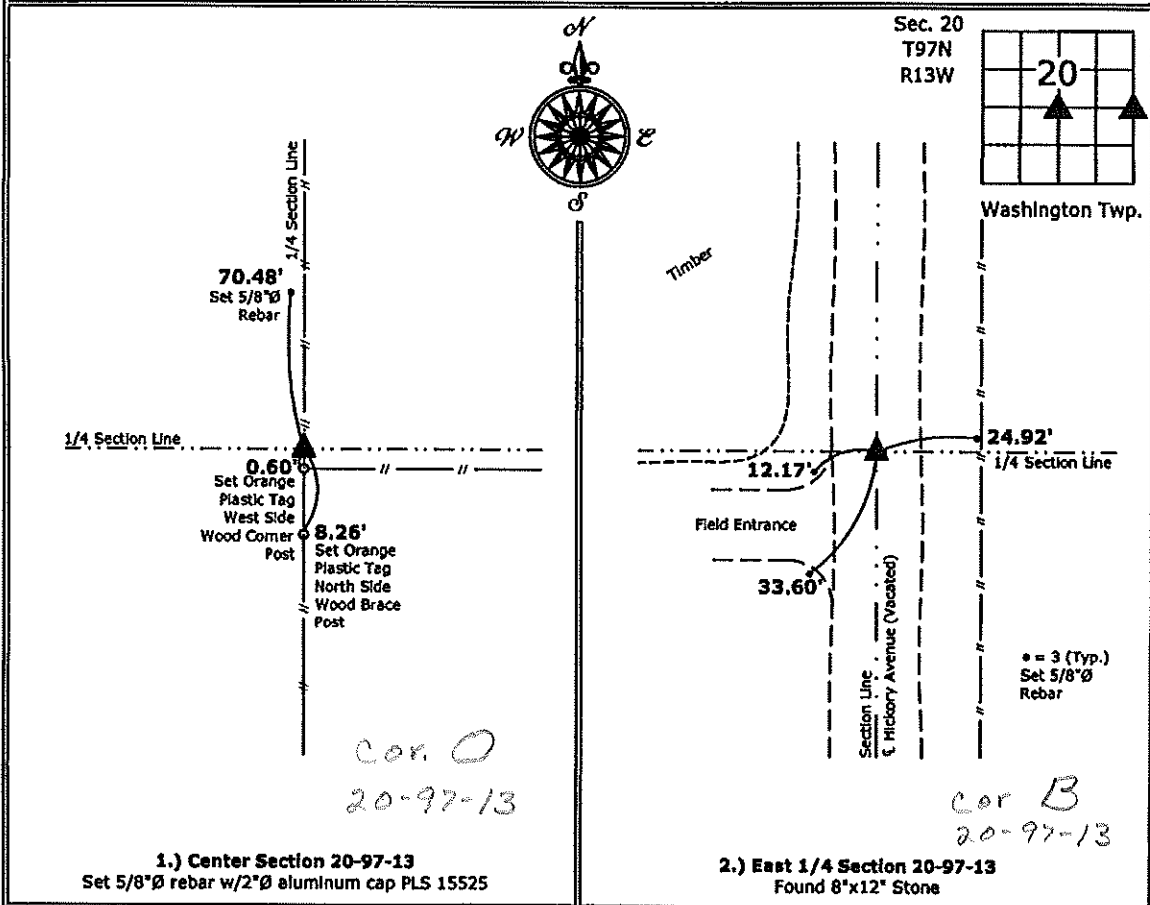

1.) **Center Section 20-97-13**
 Set 5/8"Ø rebar w/2"Ø aluminum cap PLS 15525

2.) **East 1/4 Section 20-97-13**
 Found 8"x12" Stone



I hereby certify that this land surveying document was prepared and the related survey work was performed by me or under my direct personal supervision and that I am a duly licensed Land Surveyor under the laws of the State of Iowa.

Paul R. Herold 11-30-12
 Paul R. Herold Date:

License number 15525
 My license renewal date is December 31, 2012.
 Sheets covered by this seal: Individual sheet only

List Corners to be Indexed			
Corners	Section	Twp.	Range
CTR	20	97	13
E 1/4	20	97	13

Project Number: 2012-128
 FB: Alta Vista 1, Pgs. 3-4