

prepared by & Return to: Herold - Reicks Surveying, 10 East Main Street, New Hampton, IA 50655, Ph. 641-394-2725

UNITED STATES PUBLIC LAND SURVEY CORNER CERTIFICATE

Land Survey Monuments situated in Section **26**, Township **97** North, Range **13** West of the Fifth Principal Meridian, **Chickasaw** County, Iowa. **1.)** Previously recorded in Bk. 151, Pg. 49 in the County Recorder's office. **2.)** Not previously recorded in the County Recorder's office.

This certificate is being prepared in compliance with Iowa Code Chapter 355.11 because:

- 1 & 2 There is no certificate on file for this corner.
 There are no longer three valid ties of record.
 There are changes to reference ties of record.
 There is change of monumentation of record.
 To clarify description of record monument (ties).


Monument Description and Remarks:

1.) West 1/4 Corner: Fd. 1/2"Ø Iron Pin with information obtained from the previous Section Corner Certificate. No ties remained, set new ties to update corner.

2.) Center: Set 5/8"Ø rebar w/2"Ø aluminum cap PLS 19211 at the intersection of 1/4 Section Lines. There is no record of the perpetuation of a monument at this Corner.


PLAN - VIEW

(Show a minimum of three reference ties to durable physical objects, relevant monuments and physical conditions that will enable recovery of the corner.)

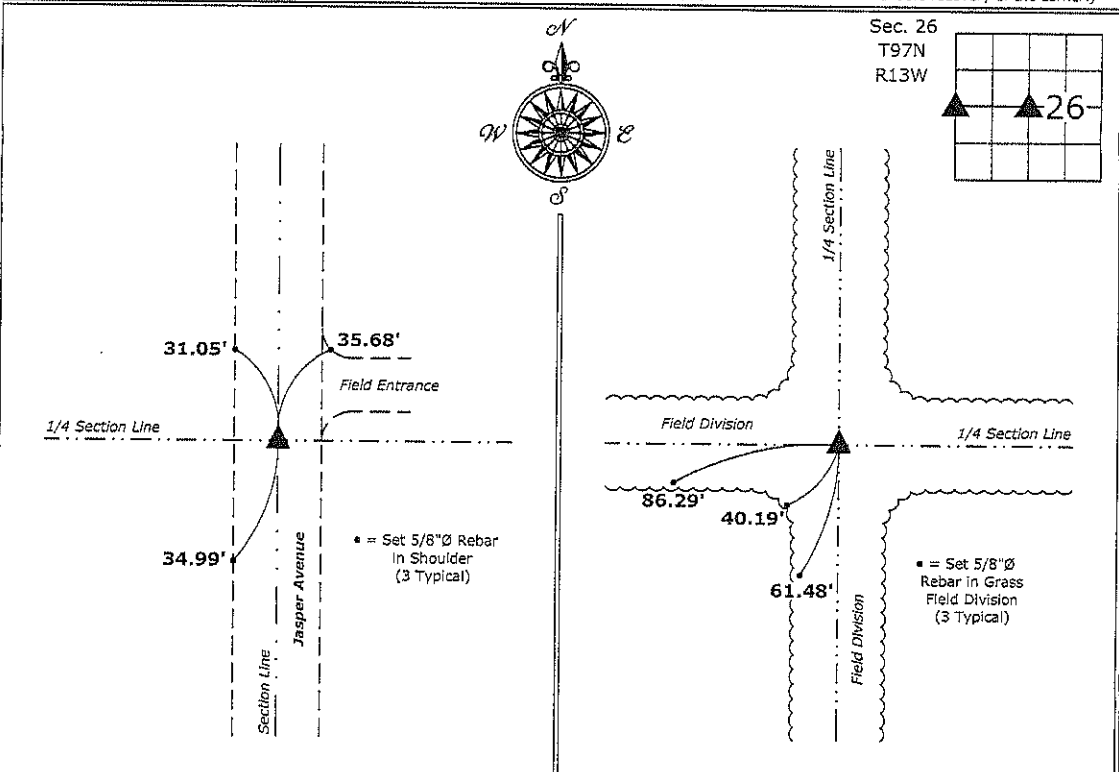

COR. C Sec 26-97-13
1.) West 1/4 Corner Section 26-97-13
 Fd. 1/2"Ø Iron Pin

COR. O Sec 26-97-13
2.) Center of Section 26-97-13
 Set 5/8"Ø rebar w/2"Ø aluminum cap PLS 19211

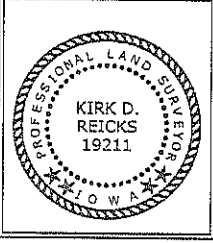

I hereby certify that this land surveying document was prepared and the related survey work was performed by me or under my direct personal supervision and that I am a duly licensed Land Surveyor under the laws of the State of Iowa.
Kirk D. Reicks 8-30-16
 Kirk D. Reicks Date:
 License number 19211
 My license renewal date is December 31, 2016.
 Sheets covered by this seal: Individual sheet only

List Corners to be Indexed			
Corners	Section	Twp.	Range
W 1/4	26	97	13
CTR	26	97	13

Project Number: 2016-093
 FB: Chickasaw County 7, Pgs. 74-75

File: S:_CAD Projects\County Control Systems\CHICKASAW\CHICK-4\CHICK-4.dwg, 8/30/2016 10:01:14 AM