

Chickasaw Co. Recorder
 Cindy Messersmith
 Fee Book 2012-0799
 04/24/2012 @1131AM
 SEC COR CERT
 Book: Page: # Pages: 1
 Total Fees: \$7.00

TeKIPPE ENGINEERING, P.C., 128 South Vine Street, West Union, Iowa 52175 Phone (563) 422-5131

UNITED STATES PUBLIC LAND SURVEY CORNER CERTIFICATE

OF 20

Land Survey Monuments situated in Section 29, Township 97 North, Range 13 West of the Fifth Principal Meridian, Chickasaw County, Iowa. Previously recorded in (1) Bk. 154, Pg. 496 (2) Doc. #2004-0373 in County Recorder's Office. (book, page, document number, etc.)

(Show reason for preparing this certificate, the evidence and detailed procedures used in establishing the corner positions and monumentation found or placed.)

Monument Description and Remarks: (1) N1/4 Corner of Section 29-T97N-R13W:

Found rusted off nail in hole of H.M.A. roadway matching two remaining ties of record. Reestablished monument with 1/2" rebar w/2" aluminum cap LS 7060. Updating certificate because one tie of record was missing and existing monumentation was not adequate.



(2) Center of Section 29-T97N-R13W:

Found 3/4" rebar with 2" aluminum cap #11442. Updating certificate because all ties of record had been grown over, so set three new ties.

PLAN VIEW

Project Number 121019.LS
 Field Book: 46M, Pages 75-76

Show a minimum of three reference ties to durable physical objects, relevant monuments and physical conditions that will enable recovery of the corner.

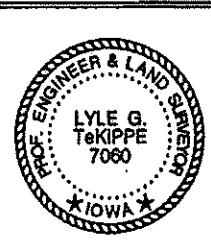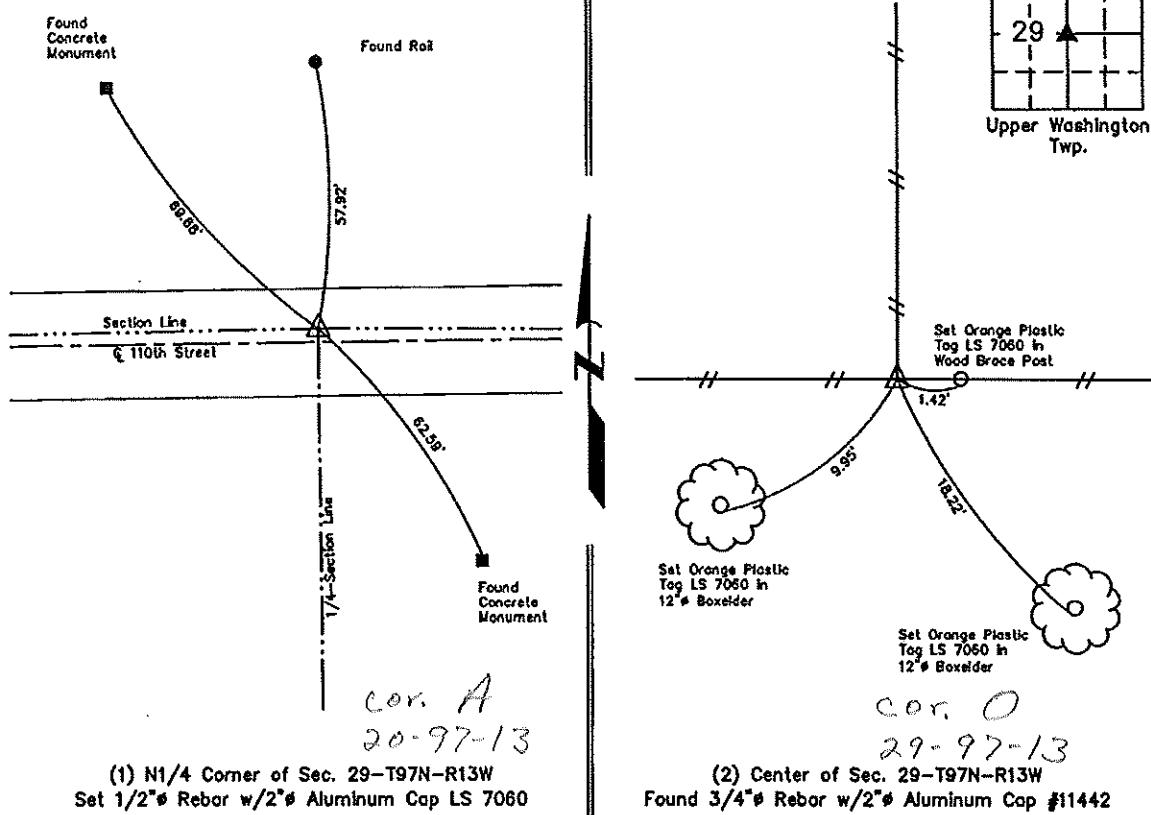

I hereby certify that this land surveying document was prepared and the related survey work was performed by me or under my direct personal supervision and that I am a duly licensed Land Surveyor under the laws of the State of Iowa.
 Lyle G. TeKIPPE, P.E. & P.L.S.
 License Number 7060
 My license renewal date is December 31, 2012.
 Sheets covered by this seal: This Sheet Only

4-18-12
 Date

List Corners to be Indexed

Corners	Section	Twp.	Range
N1/4	29	97N	13W
Center of	29	97N	13W

X:\Section Corners\Sec. 29\29-97-13CM.dwg

UNITED STATES PUBLIC LAND SURVEY CORNER CERTIFICATE

OF 20

Land Survey Monuments situated in Section 29, Township 97 NORTH, Range 13 WEST, of the Fifth Principal Meridian, CHICKASAW County, Iowa. Previously recorded in Deeds Book 150, Pg. 373 in County Recorder's Office.

(Show reason for preparing this certificate, the evidence and detailed procedures used in establishing the corner positions and monumentation found or placed.)

Monument Description and Remarks: $N\frac{1}{4}$ CORNER, SECTION 29-T 97N-R 13W:


Set PK Nail from Ties & Mag. Reading. Previously recorded cert. did not show dist. to conc. monuments.

PLAN - VIEW

(Show a minimum of three reference ties to durable physical objects, relevant monuments and physical conditions that will enable recovery of the corner.)



Fd. Conc. Mon. 3 Typ.

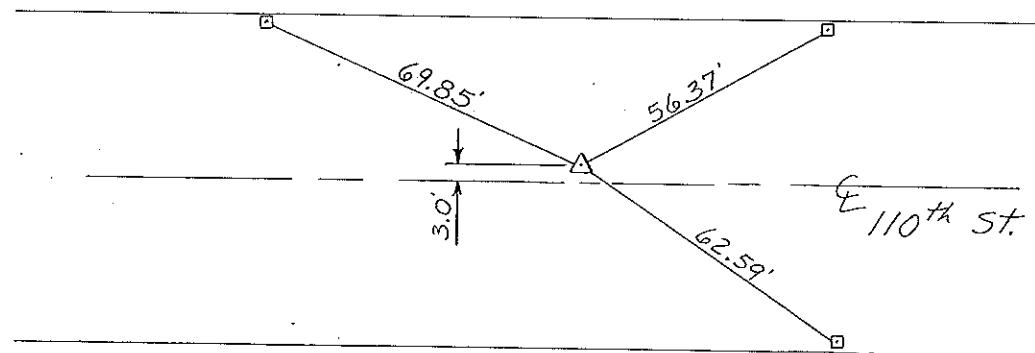

Cor. A

20-97-13

$N\frac{1}{4}$ Corner, Section 29-T 97N-R 13W

I hereby certify that the survey work was completed and this certificate was prepared by me or under my direct personal supervision and that I am a duly registered land surveyor under the laws of the state of Iowa.

Signature: Gary L. Casady
Name typed or printed: Gary L. Casady

Date: 4-26-94 Reg. No. 12532

My Registration Expires December 31, 1994

SEAL



Corners	Section	Twp	Range
$N\frac{1}{4}$	29	97N	13W

Corner A 20-97-13

Placed in tie back

Placed in tie back
5/24/94
JPM

154-496