

Section 30-97-13
As referred to in
Eng. Tie Book

TeKIPPE ENGINEERING, P.C., 128 South Vine Street, West Union, Iowa 52176 Phone (319) 422-5131

UNITED STATES PUBLIC LAND SURVEY CORNER CERTIFICATE

OF 30

Land Survey Monuments situated in Section 29, Township 97 North, Range 13 West, of the Fifth Principal Meridian, CHICKASAW County, Iowa.
Previously recorded in NONE in County Recorder's Office.


(Show reason for preparing this certificate, the evidence and detailed procedures used in establishing the corner positions and monumentation found or placed.)

Monument Description and Remarks: W 1/4 CORNER SECTION 29 T 97N R 13W: SET PK NAIL
AT RECORD POSITION, BASED ON A SURVEY AND PLAT MADE BY STEVEN L. BUSSE, RECORDED
MAY 4, 1993, AND A SURVEY AND PLAT MADE BY L.P. ERDMAN, DATED NOVEMBER 5, 1992, RECORDED
FEBRUARY 8, 1995, AFTER LOOKING INTO THE 2 SURVEYS IT WAS OBVIOUS THEY BOTH USED THE SAME
CORNER. HOWEVER, NEITHER SURVEYOR FILED A SECTION CORNER CERTIFICATE.

SW CORNER SECTION 29 T97N R13W; FOUND CEMENT NAIL AS SHOWN ON A SURVEY AND PLAT
MADE BY L.P. ERDMAN, RECORDED FEBRUARY 8, 1995, NO PREVIOUS SECTION CORNER CERTIFICATE ON FILE.

PLAN - VIEW

(Show a minimum of three reference ties to durable physical objects, relevant monuments and physical conditions that will enable recovery of the corner.)

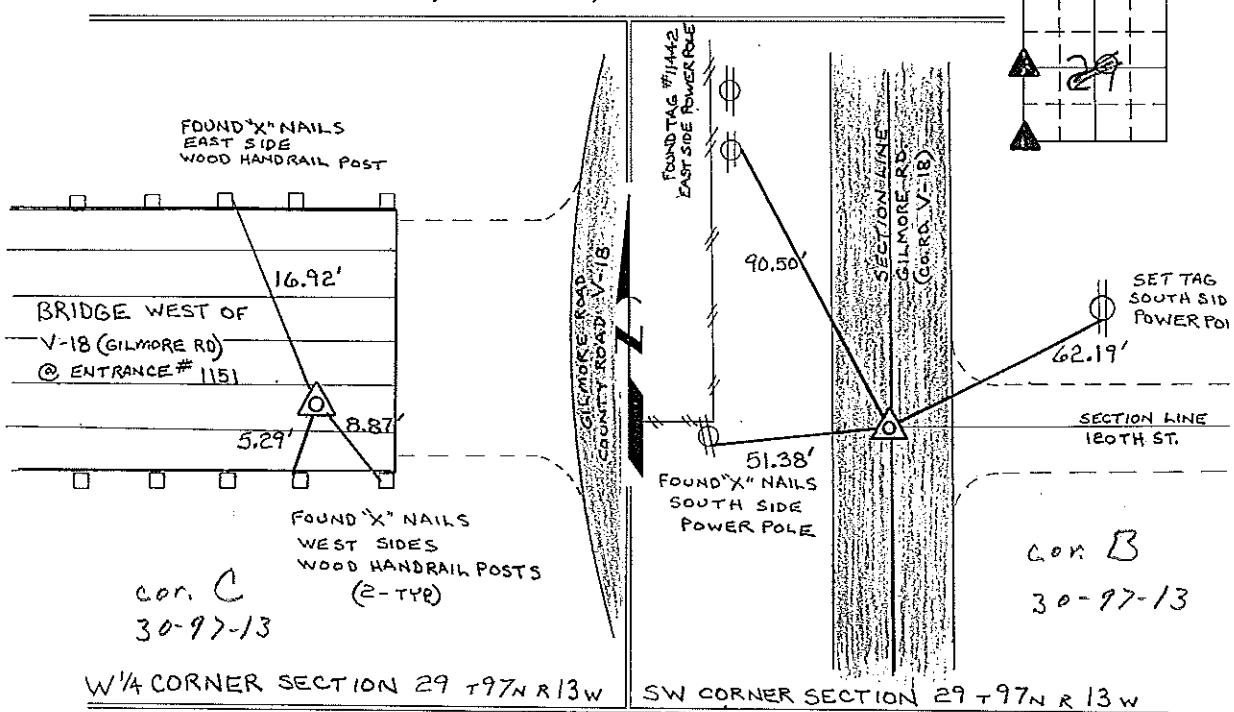

I hereby certify that the survey work was completed and this certificate was prepared by me or under my direct personal supervision and that I am a duly registered land surveyor under the laws of the state of Iowa.

Signature: 
Lyle G. TeKippe

Date: 11-18-96 Reg. No. 7080
My Registration Renewal Date is December 31, 1996

Seal



List Corners to be Indexed			
Corners	Section	Twp.	Range
W $\frac{1}{4}$	29	97 _N	13 w
Cor C	30-97-13		
SW	29	97 _N	13 w
Cor B	31-97-13		

Placed in the Book
12/13/96

162-458

"County Engineer's Copy"