


Chickasaw Co. Recorder
 Cindy Messersmith
Fee Book 2007-0787
 04/23/2007 @1001AM
 SCC: SEC COR CERT
 Book: Page: # Pages: 1
 Total Fees: \$7.00

Section 30-97-13
 As referred to in
 Engr. Fee Book

30
UNITED STATES PUBLIC LAND SURVEY CORNER CERTIFICATE
 Land Survey Monuments situated in:
 Section 31, Township 97 North, Range 13 West of the Fifth Principal Meridian,
Chickasaw County, Iowa. Previously recorded in None
 in County Recorder's Office. (book, page, document number, etc.)

(Show reason for preparing this certificate, the evidence and detailed procedures used in establishing the corner positions and monumentation found or placed.)
 Monument Description and Remarks:
 W 1/4 Corner of Section 31-97-13, Fd. 1/2"Ø Square Twisted Iron Bar from information obtained from the County Engineer's office, in Field Book Upper Deerfield Twp., Section 36, Corner "C"
 N 1/4 Corner Section 31-97-13, Set 1/2"Ø rebar w/2"Ø Aluminum Cap PLS 15525 at the existing corner post, after comparing the distances to adjacent corners.

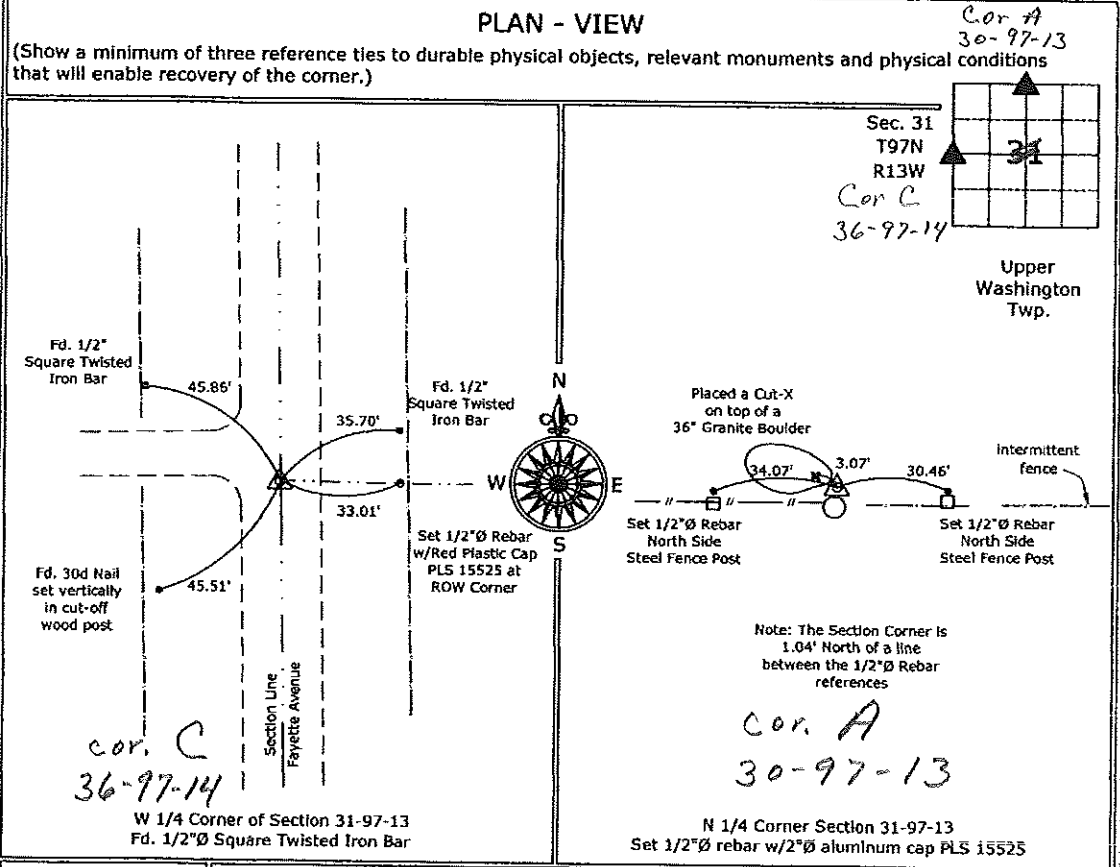

I hereby certify that this land surveying document was prepared and the related survey work was performed by me or under my direct personal supervision and that I am a duly licensed Land Surveyor under the laws of the State of Iowa.
Paul R. Herold 4-20-07
 Paul R. Herold Date:
 License number 15525
 My license renewal date is December 31, 2008.
 Sheets covered by this seal: Sheet P1

List Corners to be Indexed			
Corners	Section	Twp.	Range
W 1/4	31	97	13
N 1/4	31	97	13

Project Number: 2007-036
 FB: Chickasaw County 1, Pgs. 11-12

File: S:\Projects\2007\2007-036\dwg\2007-036.dwg, 4/20/2007 3:22:53 PM