

DOCUMENT No. <u>109999</u>	FILED FOR RECORD THE <u>6th</u> DAY OF <u>STATE OF IOWA, CHICKASAW COUNTY,</u>
RECORDING FEE <u>\$ 6.00</u>	December <u>19, 95</u> AT <u>8:30</u> <u>Leitha W. Ross</u> Recorder
S. TRANSFER FEE <u>\$ -----</u>	O'CLOCK A.M. BOOK <u>159</u> Deed <u>296</u> PAGE <u>-----</u> By <u>Leitha N. Ross</u> Deputy

Section 31-97-13
As referred to in
Engr. Tie Book

United States Public Land Survey Corner Certificate

31 of


Land Survey Monuments situated in Section, 32 Township, 97N Range, 13W of the Fifth Principle Meridian, Chickasaw County, Iowa. Previously recorded in does not apply County Recorders Office.

(Show reason for preparing this certificate, the evidence and detailed procedures used in establishing the corner positions and monumentation found or placed.)

Monument Description and Remarks: This certificate is prepared in accordance with Section 355.11 of the 1995 Code of Iowa. No previous certificate has been filed for this corner location. Based on recorded plat from 1990 in Book 146, page 194 at the Chickasaw County Recorder's office we found a cut "X" in paving described previously as the W 1/4 corner, Section 32-97-13.

Plan-View

(Show a minimum of three reference ties to durable physical objects, relevant monuments and physical conditions that will enable recovery of the corner.)

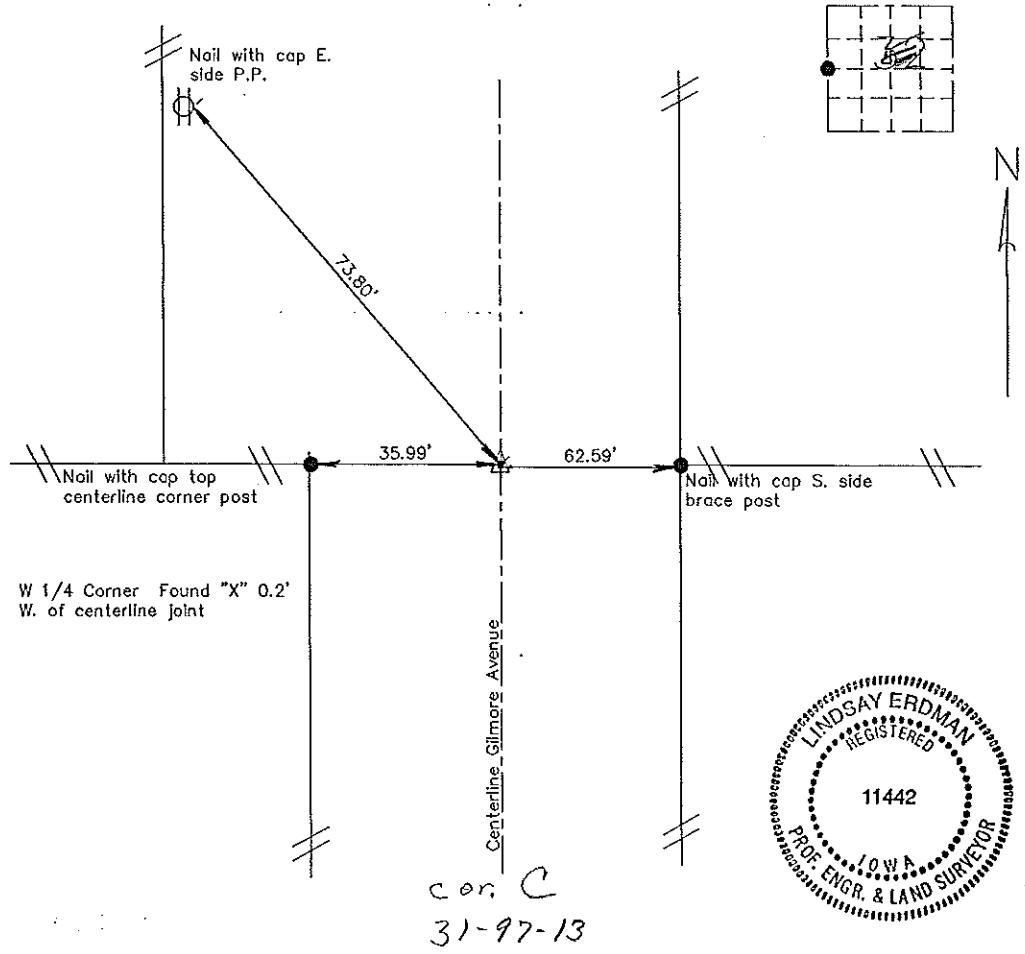

I hereby certify that the survey work was completed and this certificate was prepared by me or under my direct supervision and that I am a duly registered land surveyor under the laws of the State of Iowa.

Signature 
Lindsay Erdman, P.E. and L.S.

Date: 12/15/95 Reg. No. 11442

My license will be renewed January 1, 1997

List Corners to be Indexed

Car C 31-97-13

2000-01-01

~~Placed in the book~~

XX DOCUMENT No. 01085 | FILED FOR RECORD THE 2nd DAY OF STATE OF IOWA, CHICKASAW COUNTY,
 RECORDING FEE \$ 5.00 December 19, 1991, AT 10:21 AM MARY C. MURRAY, Rec.
 TRANSFER FEE \$ 0.00 0 C O C HICKASAW MARY C. MURRAY
 UNITED STATES PUBLIC LAND SURVEY CORNER CERTIFICATE


SLS19-90

Land Survey Monuments situated in Section 32 30, Township 97, Range 13, of the Fifth Principal Meridian, CHICKASAW County, Iowa. Previously recorded in Does Not Apply in County Recorder's Office.
 (Show reason for preparing this certificate, the evidence and detailed procedures used in establishing the corner positions and monumentation found or placed.)

Monument Description and Remarks: _____

Section 30-97-13
 As referred to in
 Engr Tie Book

PLAN - VIEW
 (Show a minimum of three reference ties to durable physical objects, relevant monuments and physical conditions that will enable recovery of the corner.)

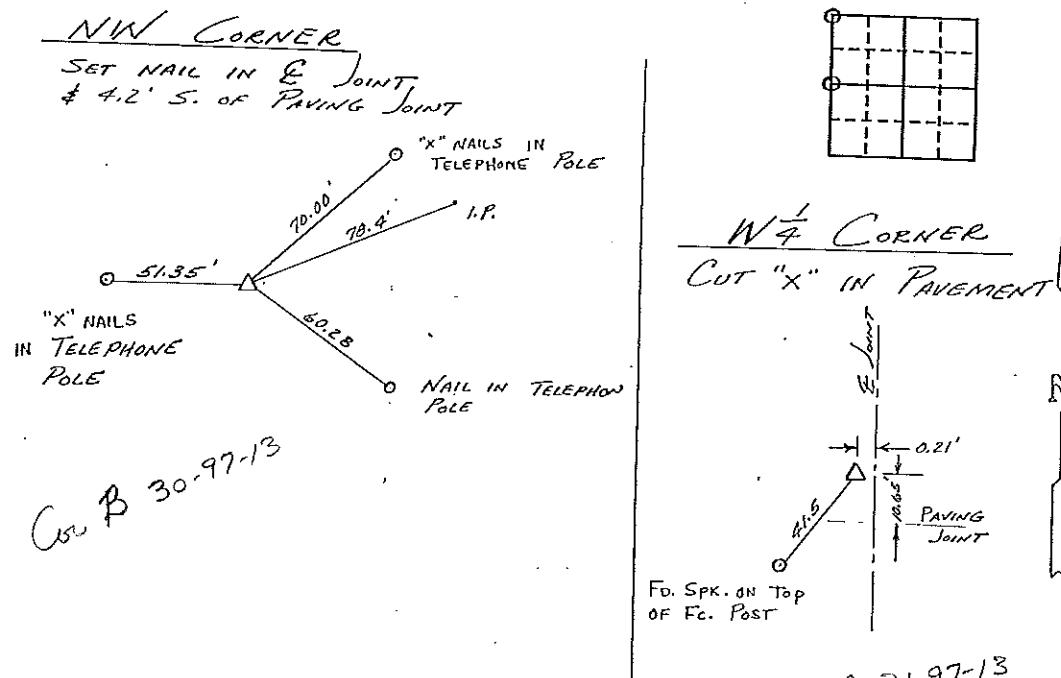

Cn C of 31-97-13

I hereby certify that the survey work was completed and this certificate was prepared by me or under my direct personal supervision and that I am a duly registered land surveyor under the laws of the state of Iowa.

Signature: L.P. Erdman
 Name typed or printed: L.P. ERDMAN

Date: 10-03-91 Reg. No. 2886

SEAL



Corners	Section	Twp	Range
NW	32	97	13
SW	32	97	13

Placed in the
 Book 12/3/91

148-258

12/11/91