

UNITED STATES PUBLIC LAND SURVEY CORNER CERTIFICATE

OF 30

Land Survey Monuments situated in Section 29, Township 97 North, Range 13 West, of the Fifth Principal Meridian, CHICKASAW County, Iowa. Previously recorded in NONE in County Recorder's Office.

(book, page, document number, etc.)


(Show reason for preparing this certificate, the evidence and detailed procedures used in establishing the corner positions and monumentation found or placed.)

Monument Description and Remarks: W 1/4 CORNER SECTION 29 T 97N R 13W: SET PK NAIL AT RECORD POSITION, BASED ON A SURVEY AND PLAT MADE BY STEVEN L. BUSSE, RECORDED MAY 4, 1993, AND A SURVEY AND PLAT MADE BY L.P. ERDMAN, DATED NOVEMBER 5, 1992, RECORDED FEBRUARY 8, 1995, AFTER LOOKING INTO THE 2 SURVEYS IT WAS OBVIOUS THEY BOTH USED THE SAME CORNER, HOWEVER NEITHER SURVEYOR FILED A SECTION CORNER CERTIFICATE.

SW CORNER SECTION 29 T 97N R 13W: FOUND CEMENT NAIL AS SHOWN ON A SURVEY AND PLAT MADE BY L.P. ERDMAN, RECORDED FEBRUARY 8, 1995, NO PREVIOUS SECTION CORNER CERTIFICATE ON FILE.

PLAN - VIEW

(Show a minimum of three reference ties to durable physical objects, relevant monuments and physical conditions that will enable recovery of the corner.)

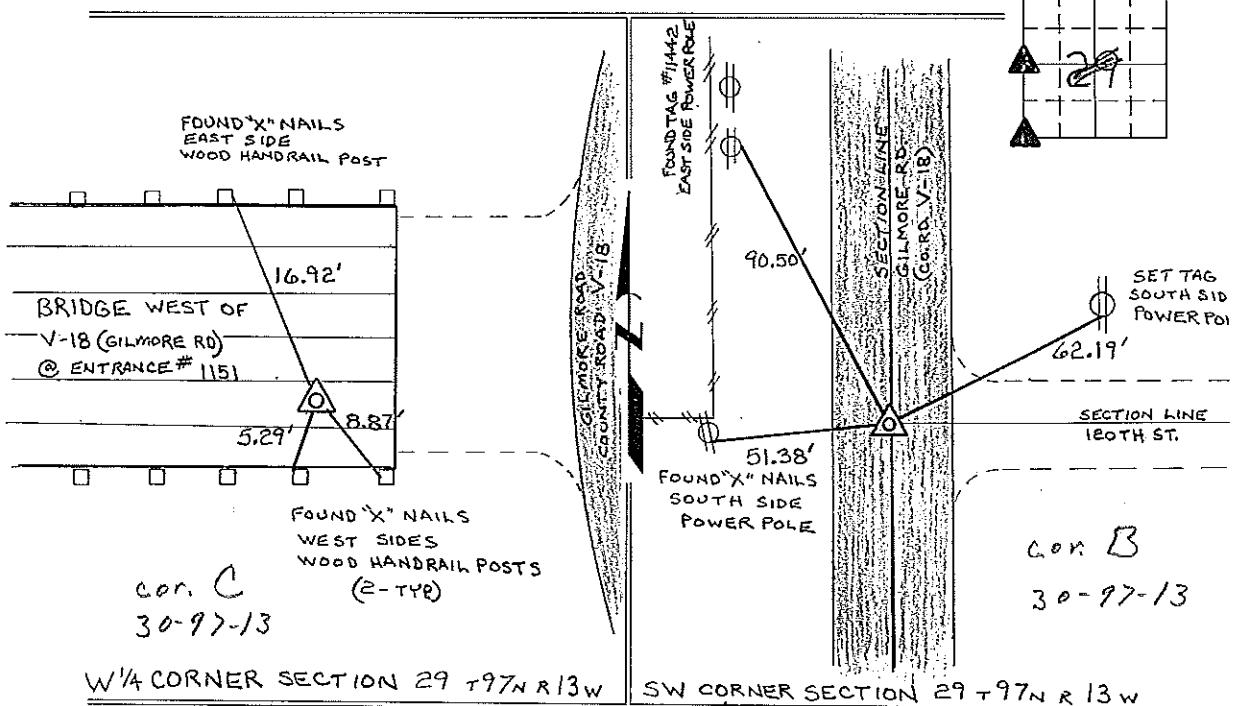

I hereby certify that the survey work was completed and this certificate was prepared by me or under my direct personal supervision and that I am a duly registered land surveyor under the laws of the state of Iowa.

Signature Lyle G. TeKippe
Lyle G. TeKippe

Date: 11-18-96 Reg. No. 7080
My Registration Renewal Date is December 31, 1996

Seal



List Corners to be Indexed			
Corners	Section	Twp.	Range
W 1/4	29	97N	13W
SW	29	97N	13W

Cor C 30-97-13
Cor B-30-97-13

Placed in the Book
12/13/96

01000

DOCUMENT NO. 01000 | FILED FOR RECORD THE 6th DAY OF DECEMBER 1995 AT 8:30 AM
 RECORDING FEE \$ 6.00 | STATE OF IOWA, CHICKASAW COUNTY
 S. TRANSFER FEE \$ 0.00 | Deed PAGE 297 By Leitha N. Ross, Recorder
Leitha N. Ross, Deputy

Section 30-97-13
 As referred to in
 my Tie Book

United States Public Land Survey Corner Certificate

30 of


Land Survey Monuments situated in Section, 32 Township, 97 Range, 13W of the Fifth Principle Meridian, Chickasaw County, Iowa. Previously recorded in does not apply in County Recorders Office.

(Show reason for preparing this certificate, the evidence and detailed procedures used in establishing the corner positions and monumentation found or placed.)

Monument Description and Remarks: This certificate is prepared in accordance with Section 355.11 of the 1995 Code of Iowa. No previous certificate has been filed for this corner location. Based on recorded plat from 1990 in Book 146, page 194 at the Chickasaw County Recorders office we found an A.C. nail in the centerline paving joint described previously as the NW corner of Section 32-97-13. The A.C. nail location was verified by overall distance to the W 1/4 corner measured as 2810.89' (2810.89' rec.)

Plan-View

(Show a minimum of three reference ties to durable physical objects, relevant monuments and physical conditions that will enable recovery of the corner.)

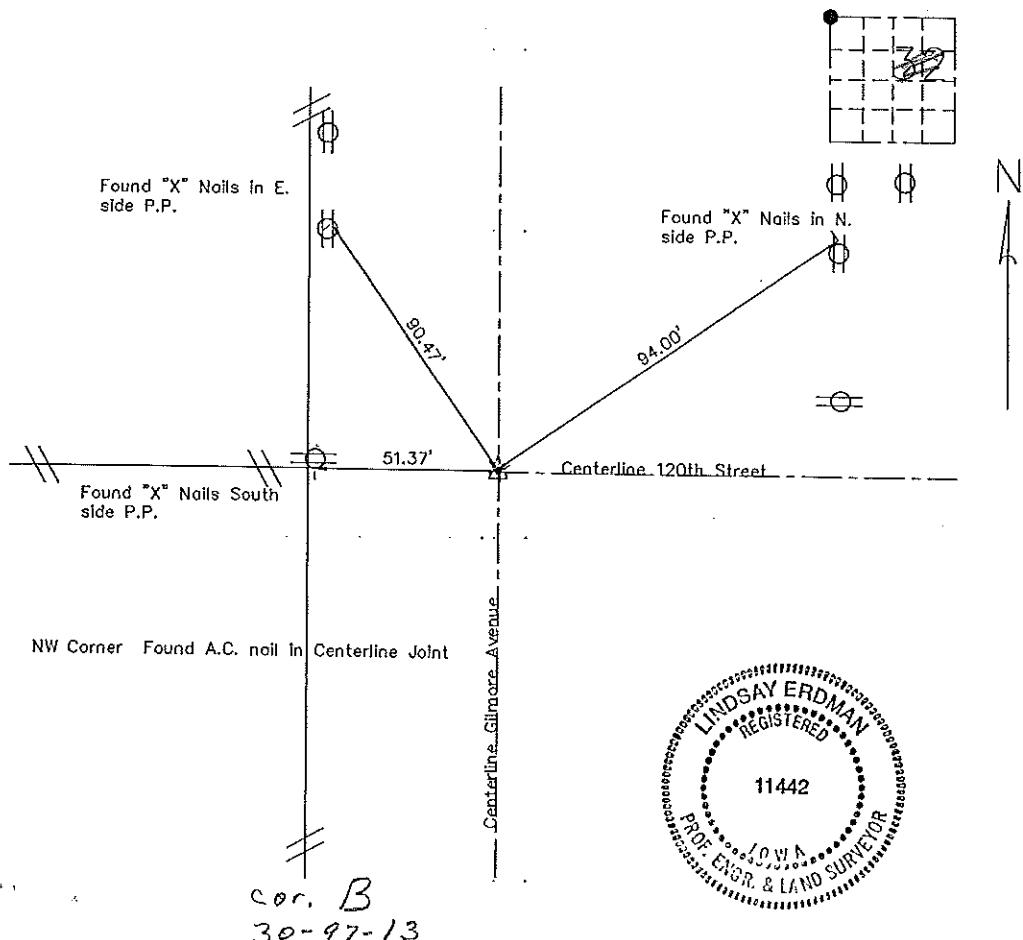

I hereby certify that the survey work was completed and this certificate was prepared by me or under my direct supervision and that I am a duly registered land surveyor under the laws of the State of Iowa.

Signature Lindsay Erdman
 Lindsay Erdman, P.E. and L.S.
 Date: 12/5/95 Reg. No. 11442

My license will be renewed January 1, 1997

List Corners to be indexed
 Corners Section Twp. Range

NW Corner 32 97 13

Cor. B - 36-97-13

Placed in the Book

XX DOCUMENT No. 01085 | FILED FOR RECORD THE 2nd DAY OF STATE OF IOWA, CHICKASAW COUNTY,
 RECORDING FEE \$ 5.00 | December 19, 1991, AT 10:21 AM MARY C. MURRAY, Rec.
 TRANSFER FEE \$ | 0 CLOCK A.M. BOOK 148, DEEDS PAGE 252 BY MARY C. MURRAY
 SLS19-90

UNITED STATES PUBLIC LAND SURVEY CORNER CERTIFICATE

OF

Land Survey Monuments situated in Section 32 30, Township 97, Range 13, of the Fifth Principal Meridian, CHICKASAW County, Iowa.


Previously recorded in Does Not Apply in County Recorder's Office.

(Show reason for preparing this certificate, the evidence and detailed procedures used in establishing the corner positions and monumentation found or placed.)

Monument Description and Remarks:

Section 30-97-13
As referred to in
Engr Tie Book

PLAN - VIEW
(Show a minimum of three reference ties to durable physical objects, relevant monuments and physical conditions that will enable recovery of the corner.)

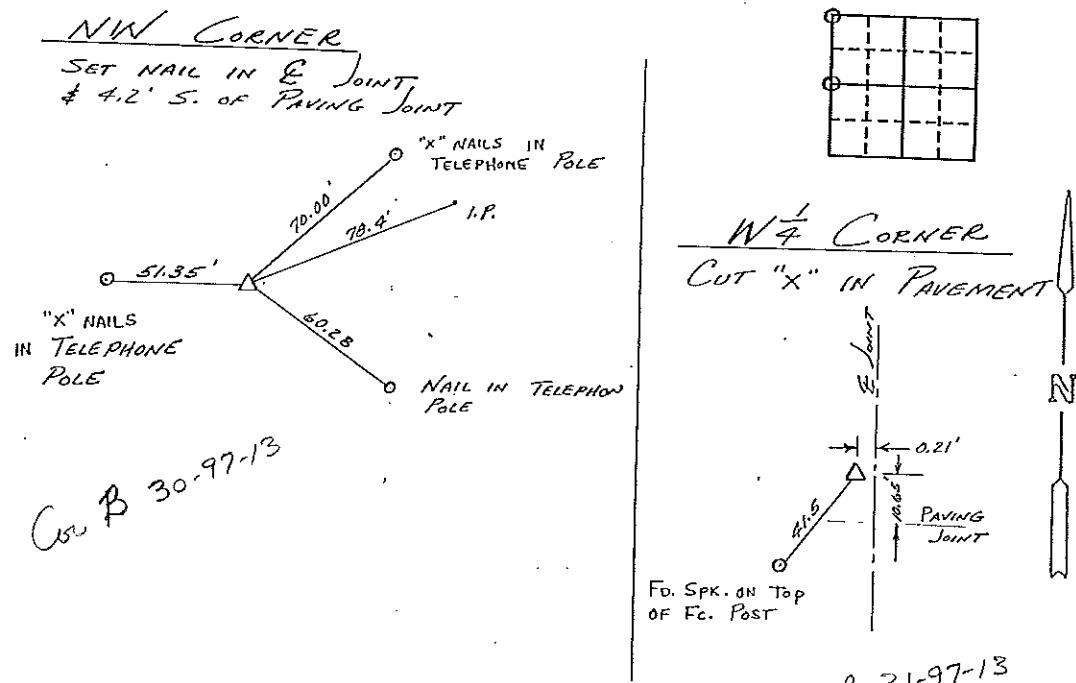

Cn C of 31-97-13

I hereby certify that the survey work was completed and this certificate was prepared by me or under my direct personal supervision and that I am a duly registered land surveyor under the laws of the state of Iowa.

Signature: L.P. Erdman
Name typed or printed: L.P. ERDMAN

Date: 10-03-91 Reg. No. 2886

SEAL



Corners	Section	Twp	Range
NW	32	97	13
W 1/4	32	97	13

Placed in the
Book 12/3/91