

DOCUMENT No. 00000 FILED FOR RECORD THE 14th DAY OF STATE OF IOWA, CHICKASAW COUNTY
 RECORDING FEE \$ 6.00 September 1993 AT 9:24
 TRANSFER FEE \$ 00:00 O'CLOCK A.M. BOOK 153 Deed PAGE 40 By *L.P. Erdman* Recorder
 LEITHA N. ROSS Deputy

UNITED STATES PUBLIC LAND SURVEY CORNER CERTIFICATE

OF 27

*Section 27-97-13
 As referred to in
 Engr. Title Book*


Land Survey Monuments situated in Section 35, Township 97N, Range 13W, of the Fifth Principal Meridian, Chickasaw County, Iowa.
 Previously recorded in does not apply in County Recorder's Office.
(book, page, document number, etc.)

(Show reason for preparing this certificate, the evidence and detailed procedures used in establishing the corner positions and monumentation found or placed.)

Monument Description and Remarks: See below

PLAN - VIEW

(Show a minimum of three reference ties to durable physical objects, relevant monuments and physical conditions that will enable recovery of the corner.)

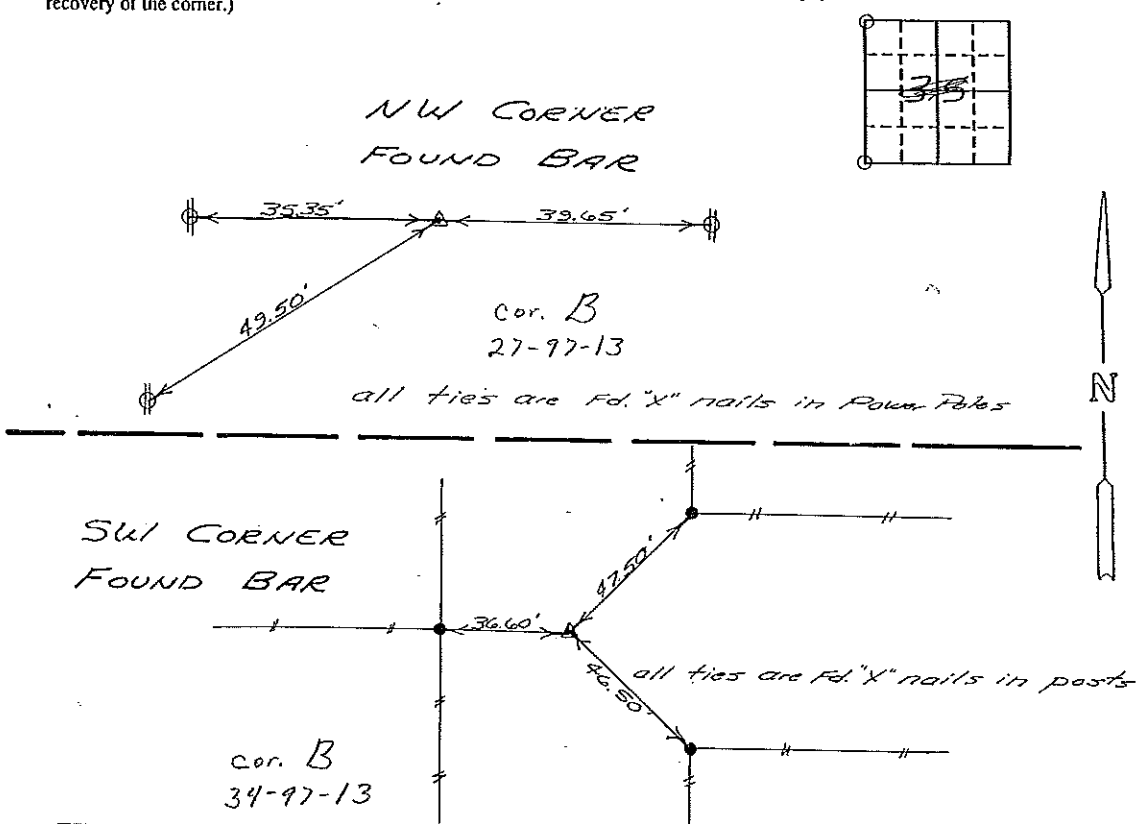

I hereby certify that the survey work was completed and this certificate was prepared by me or under my direct personal supervision and that I am a duly registered land surveyor under the laws of the state of Iowa.

Signature: *L.P. Erdman*
 Name typed or printed: L. P. Erdman
 Date: 7-21-93 Reg. No. 2886



SEAL

Corners	List Corners to be Indexed Section	Twp	Range
NW	35	97N	13W
SW	35	97N	13W

Placed in the Book 9/15/93