

Chickasaw Co. Recorder  
 Cindy Messersmith  
**Fee Book 2014-0679**  
 05/28/2014 @0240PM  
 SCC SEC COR CERT  
 Book: Page: # Pages: 1  
 Total Fees: \$7.00

Prepared by & Return to: Herald - Rocks Surveying, 10 East Main Street, New Hampton, IA 50659, Ph. 641-394-2725

**UNITED STATES PUBLIC LAND SURVEY CORNER CERTIFICATE**

Land Survey Monuments situated in Section 35, Township 97 North, Range 13 West of the Fifth Principal Meridian, Chickasaw County, Iowa. Not previously recorded in the County Recorder's office.

This certificate is being prepared in compliance with Iowa Code Chapter 355.11 because:


- There is no certificate on file for this corner.
- There are no longer three valid ties of record.
- There are changes to reference ties of record.
- There is change of monumentation of record.
- To clarify description of record monument (ties).

Monument Description and Remarks:

**East 1/4 Corner:** Found 5/8"Ø Iron pin 18" deep with information obtained from a Survey and Plat made by Thomas V. Craft, recorded July 22, 1987, in Book 138, Page 426 on file in the Chickasaw County Recorder's office, New Hampton Iowa. Set 5/8"Ø rebar w/2"Ø aluminum cap PLS 19211 overtop to perpetuate the monument.

**PLAN - VIEW**

(Show a minimum of three reference ties to durable physical objects, relevant monuments and physical conditions that will enable recovery of the corner.)

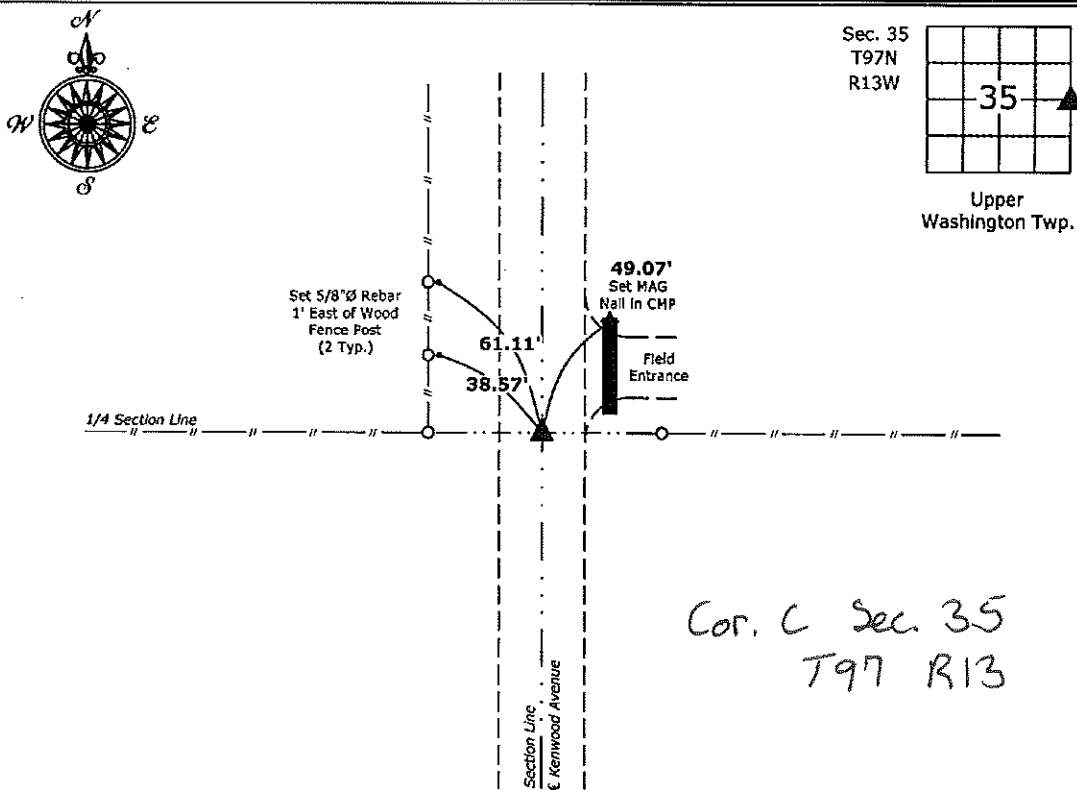

**East 1/4 Corner Section 35-97-13**

Found 5/8"Ø Iron Pin 18" Deep. Set 5/8"Ø Rebar w/2"Ø alum. cap PLS 19211 Overtop



I hereby certify that this land surveying document was prepared and the related survey work was performed by me or under my direct personal supervision and that I am a duly licensed Land Surveyor under the laws of the State of Iowa.

*Kirk D. Reicks 5-28-14*  
 Kirk D. Reicks Date:

License number 19211  
 My license renewal date is December 31, 2014.  
 Sheets covered by this seal: Individual sheet only

List Corners to be Indexed

Corners	Section	Twp.	Range
E 1/4	35	97	13

Project Number: 2014-098

FB: Chickasaw 6, Pgs. 37-38

File: S:\\_CSD Projects\County Control Systems\CHICKASAW\CHICK-4\CHICK-4.dwg, 5/17/2014 6:52:24 AM