24-25-26 TWP. 97 RANGE 15

Section 30-97-14
As referred to in
Engr. The Book

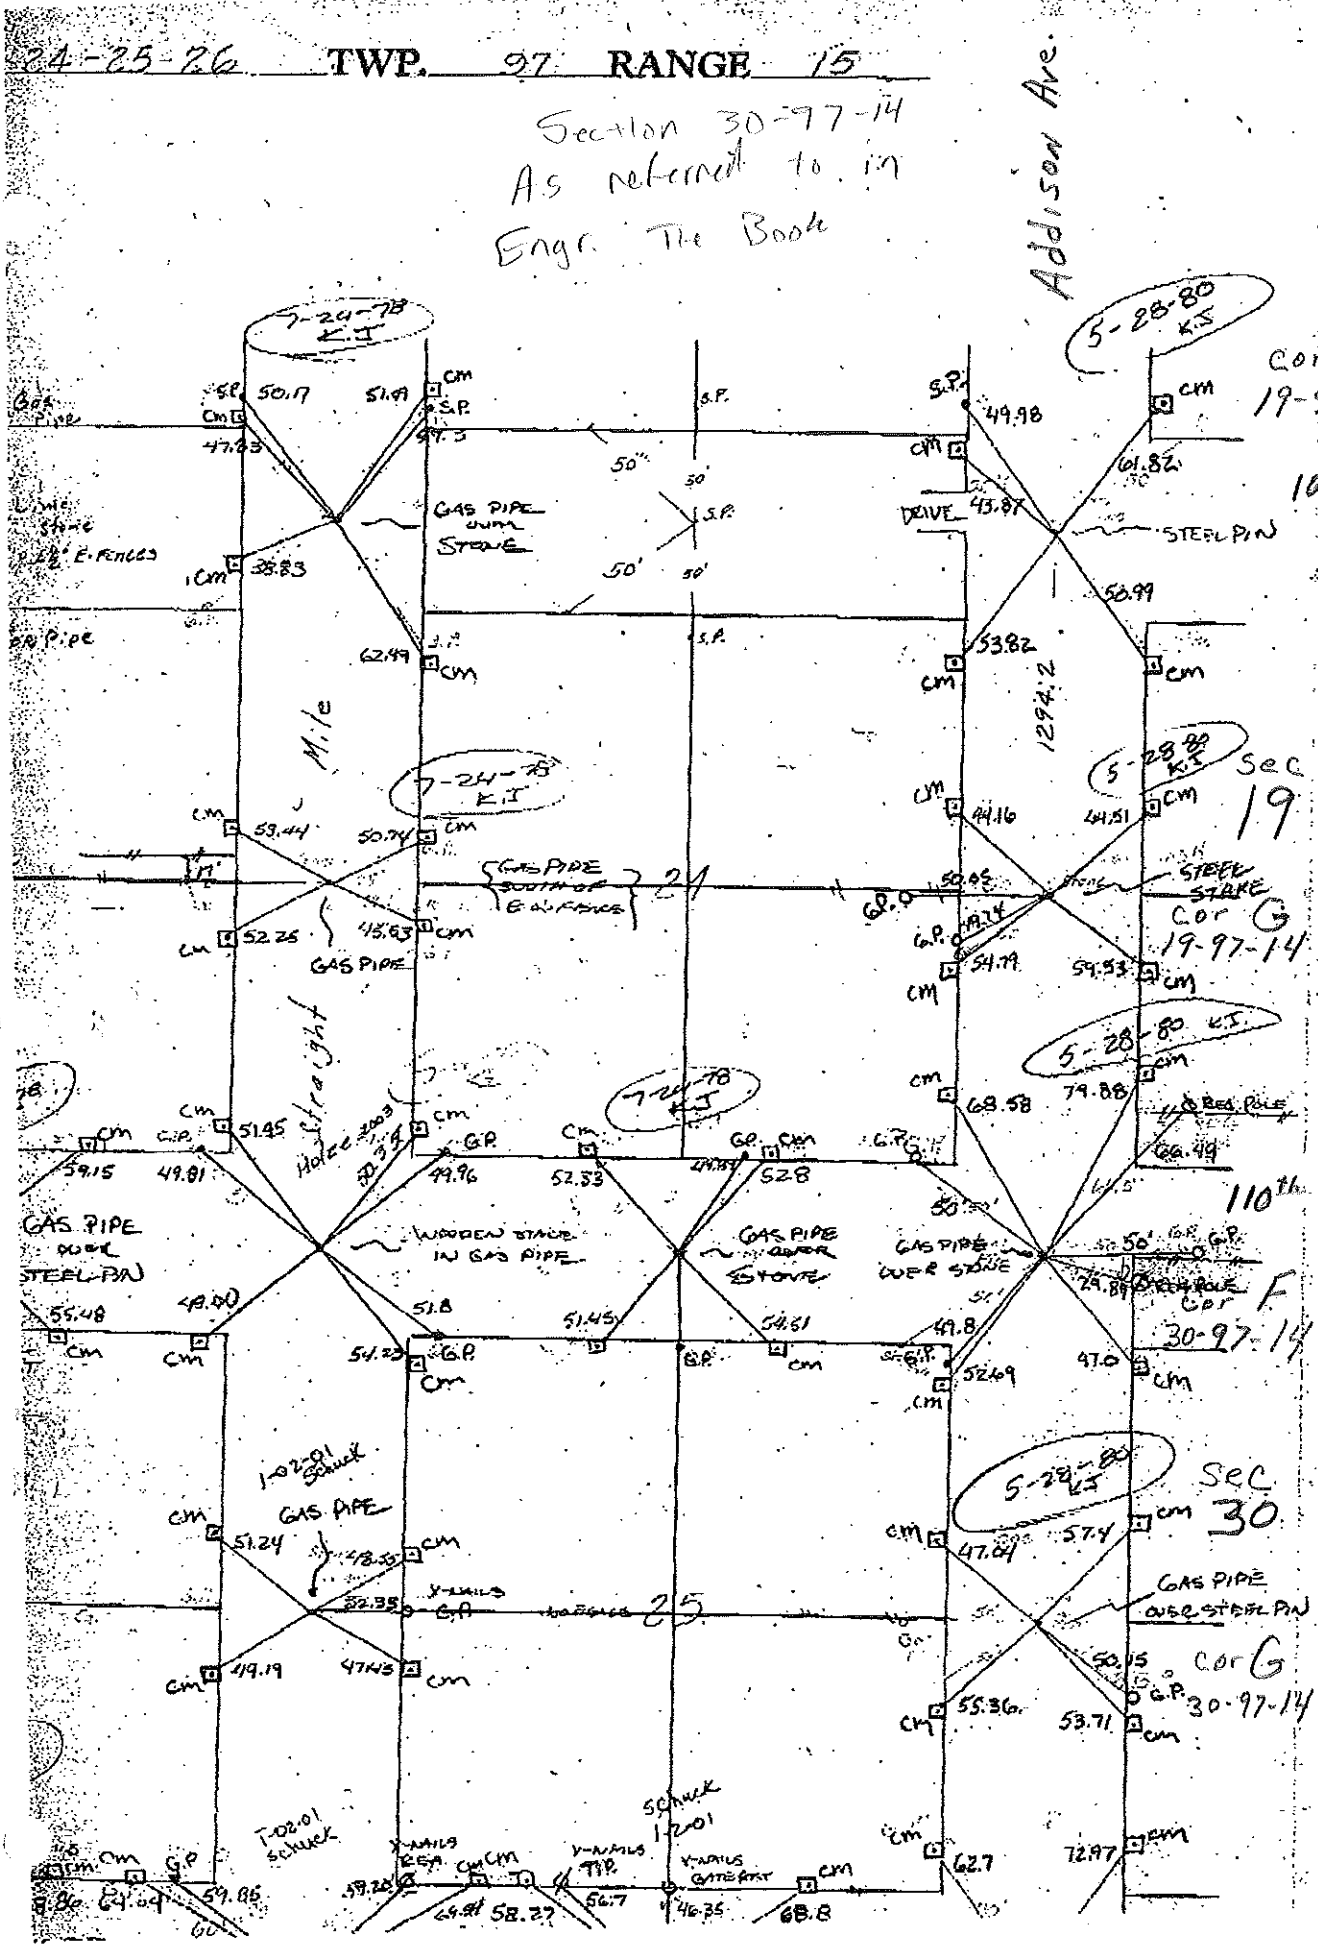

SW. corner and the S¼ corner of Section 23 Twp. 97 Range 15 had been set. The survey. As these did not fit conditions and would change all fences and road the points were set as shown. April 25th 1938. 26.8' South.