Instr. Number: 2026-1149
Recorded: 7/13/2026 at 2:16:58.0 PM
Pages 1
County Recording Fee: $7.00
Iowa E-Filing Fee: $3.00
Combined Fee: $10.00
Revenue Tax:
Shirley Troyna RECORDER
Chickasaw County, Iowa

Prepared by & Return to: Kirk D. Reicks, HRS, LLC, 10 East Main Street, New Hampton, IA 50659, Phone 641-394-2725

United States Public Land Survey Corner Certificate

Land Survey Monument situated in
Section **8**, Township **95** North, Range **14** West of the Fifth Principal Meridian, **Chickasaw** County, Iowa.
Not on file in the County Recorder's Office.

This certificate is being prepared in compliance with Iowa Code Chapter 355.11 because:

- ☒ There is no certificate on file for this corner.
- ☐ There are no longer three valid ties of record.
- ☐ There are changes to reference ties of record.
- ☐ There is change of monumentation of record.
- ☐ To clarify description of record monument (ties).

Monument Description and Remarks:

SW Corner of the NE 1/4 - NE 1/4:

Set 5/8"Ø w/2"Ø Aluminum Cap PLS 19211 at the intersection of 1/4-1/4 Section Lines.

Plan View - Not to Scale

(Show a minimum of three reference ties to durable physical objects, relevant monuments and physical conditions that will enable recovery of the corner.)

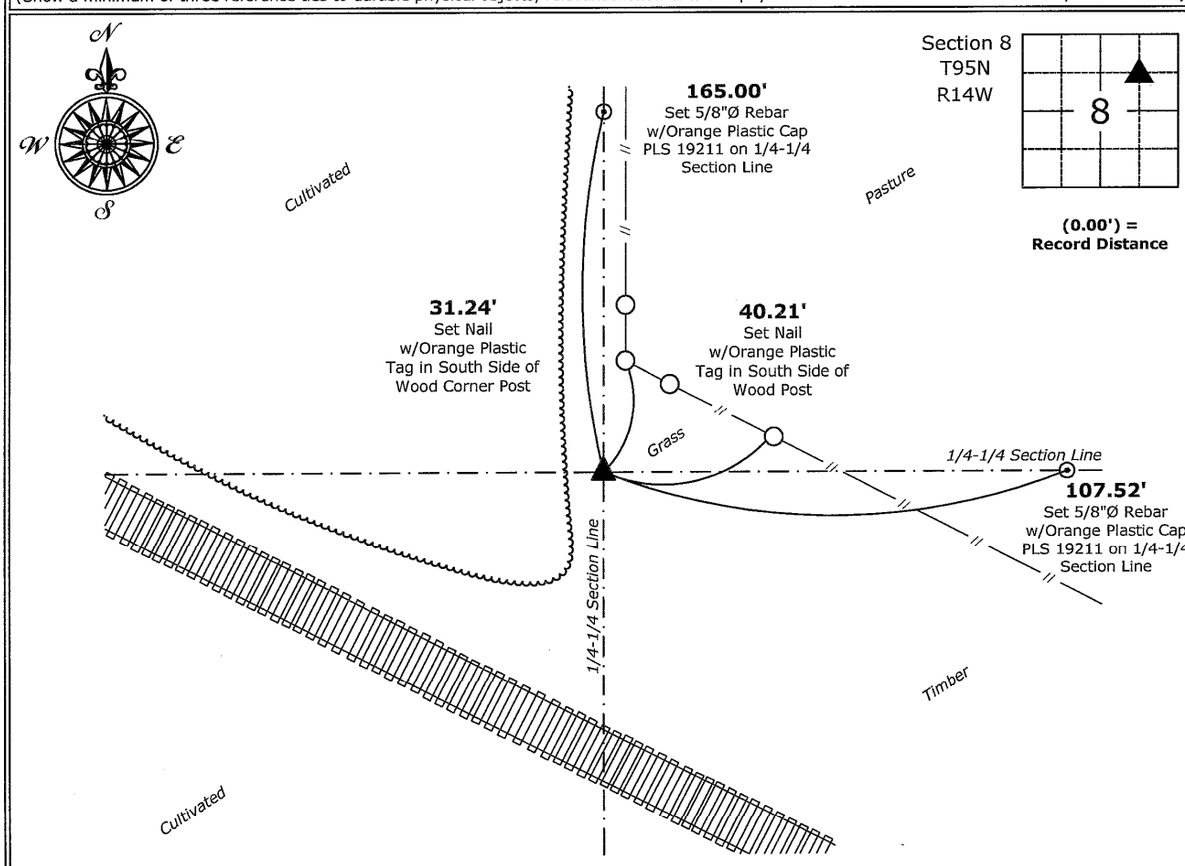

SW Corner of the NE 1/4 - NE 1/4 of Section 8-95-14
Set 5/8"Ø Rebar w/2"Ø Aluminum Cap PLS 19211

PROFESSIONAL LAND SURVEYOR
KIRK D. REICKS
19211
IOWA

I hereby certify that this land surveying document was prepared and the related survey work was performed by me or under my direct personal supervision and that I am a duly licensed Land Surveyor under the laws of the State of Iowa.

Kirk D. Reicks 7-10-2026
Kirk D. Reicks Date:

License Number 19211
My License Renewal Date is December 31, 2026.
Sheets covered by this seal: Individual sheet only

List Corner to be Indexed

Corner	Section	Township	Range
SW-NE-NE	8	95	14

Project Number: 2026-070
FB: Chickasaw 14, Page(s) 59-60

File: S:__Projects - NHO\County Control Systems\CHICKASAW\CHICK-25\CHICK-25-2026.dwg, 7/10/2026 3:22:40 PM