Instrument #: 2026-1071
06/29/2026 10:16:22 AM Total Pages: 1
SCC SECTION CORNER CERTIFICATES
Recording Fee: $ 7.00
Shirley Troyna, Recorder, Chickasaw County Iowa

Prepared by & Return to: Kirk D. Reicks, HRS, LLC, 10 East Main Street, New Hampton, IA 50659, Phone 641-394-2725

United States Public Land Survey Corner Certificate

Land Survey Monument situated in
Section **26**, Township **97** North, Range **14** West of the Fifth Principal Meridian, **Chickasaw** County, Iowa.
Not on file in the County Recorder's Office.

This certificate is being prepared in compliance with Iowa Code Chapter 355.11 because:

- ☒ There is no certificate on file for this corner.
- ☐ There are no longer three valid ties of record.
- ☐ There are changes to reference ties of record.
- ☐ There is change of monumentation of record.
- ☐ To clarify description of record monument (ties).

Monument Description and Remarks:

North 1/4 Corner:

Set 5/8"Ø Rebar w/2"Ø Aluminum Cap PLS 19211 by using record distances from the Center and Northeast Corners of said Section. Record distance information obtained from the County Engineer's Office, in Surveyor's Record Book, Page 65.

Plan View - Not to Scale

(Show a minimum of three reference ties to durable physical objects, relevant monuments and physical conditions that will enable recovery of the corner.)

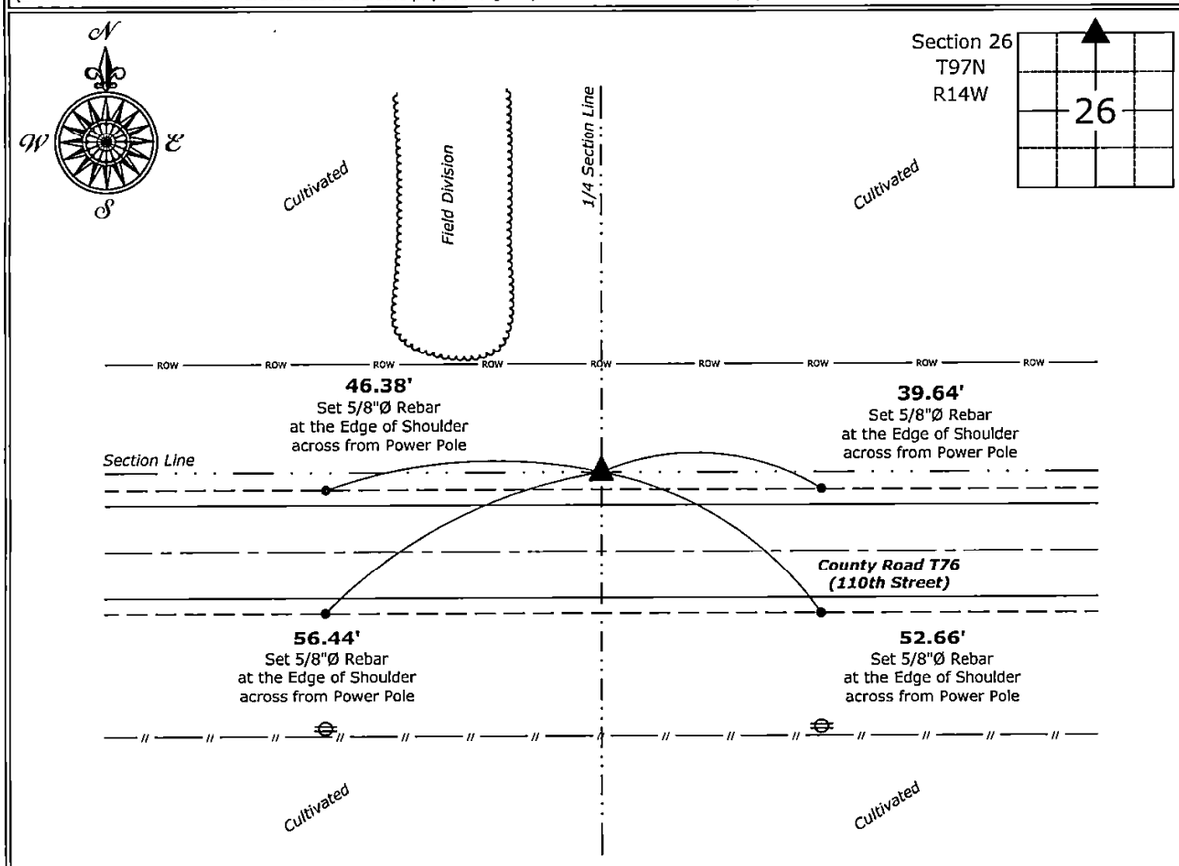

North 1/4 Corner of Section 26-97-14
Set 5/8"Ø Rebar w/2"Ø Aluminum Cap PLS 19211

PROFESSIONAL LAND SURVEYOR
KIRK D. REICKS
19211
IOWA

I hereby certify that this land surveying document was prepared and the related survey work was performed by me or under my direct personal supervision and that I am a duly licensed Land Surveyor under the laws of the State of Iowa.

Kirk D. Reicks 6-29-2026
Kirk D. Reicks Date:

License Number 19211
My License Renewal Date is December 31, 2026.
Sheets covered by this seal: Individual sheet only

List Corner to be Indexed

Corner	Section	Township	Range
N 1/4	26	97	14

Project Number: 2026-066
FB: Chickasaw 14, Page(s) 55-56

File: S:__Projects - NHO\County Control Systems\CHICKASAW\CHICK-2\CHICK-2-2026.dwg, 6/29/2026 6:43:17 AM