I DOCUMENT No. 02991	FILED FOR RECORD THE 9th DAY OF	STATE OF IOWA, CHICKASAW COUNTY:
C RECORDING FEE $ 6.00	June 19 99 AT 8:53	Cindy Messersmith Recorder
M		CINDY MESSERSMITH
S TRANSFER FEE - $	O'CLOCK A M. BOOK 172 PAGE 50	By Shirley M. Prange Deputy

Prepared by: Erdman Engineering, P.C. 708 Commerce Drive, P.O. Box 246, Decorah, Iowa 52101
Phone (319)382-4194, Fax (319)382-3623

United States Public Land Survey Corner Certificate of

Land Survey Monuments situated in Section 5 Township 94 Range 11 of the Fifth Principle Meridian, Chickasaw County, Iowa. Previously recorded in does not apply in County Recorders Office.

Monument Description and Remarks: This certificate is prepared in accordance with Section 355.11 of the 1995 Code of Iowa. No previous certificate has been filed for this corner location. Based on Chickasaw County Engineer's Reference Ties we searched for the tie marker that were previously set. We did not find any as the trees that were used have been cut down. We found a 5/8" bar that matches the description of the monument previously set at the S 1/4 Corner of Section 5, Township 94 North, Range 11 West. The bar is at the approximate centerline of the county road (260th Street) and in line with the fence lines running north and south. The bar is down ±18" below the crushed rock surface. We set a 1/2" bar w/cap Iowa RLS #11442 over the top.

Plan-View

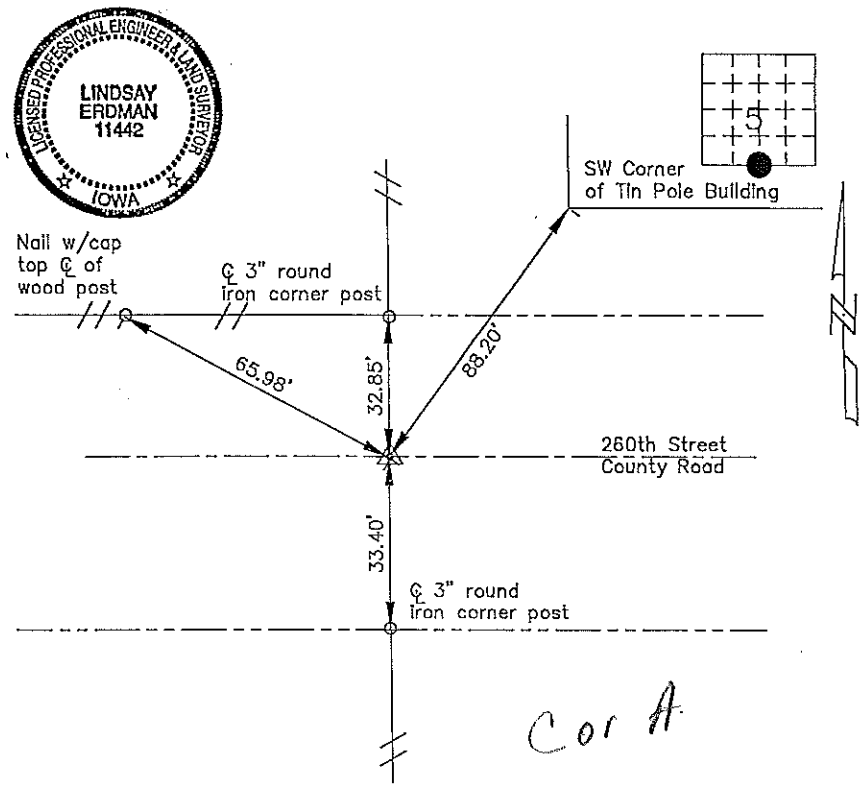

I hereby certify that the survey work was completed and this certificate was prepared by me or under my direct supervision and that I am a duly registered land surveyor under the laws of the State of Iowa.

Signature _____
Lindsay Erdman, P.E. and L.S.

Date: 6/7/99 Reg. No. 11442

My license renewal date is December 31, 2000

List Corners to be Indexed

Corners	Section	Twp.	Range
S 1/4	5	94	11

m:\c:\ecd\est\chck\99058\99058a4